T.18S. R.3W. W.M.

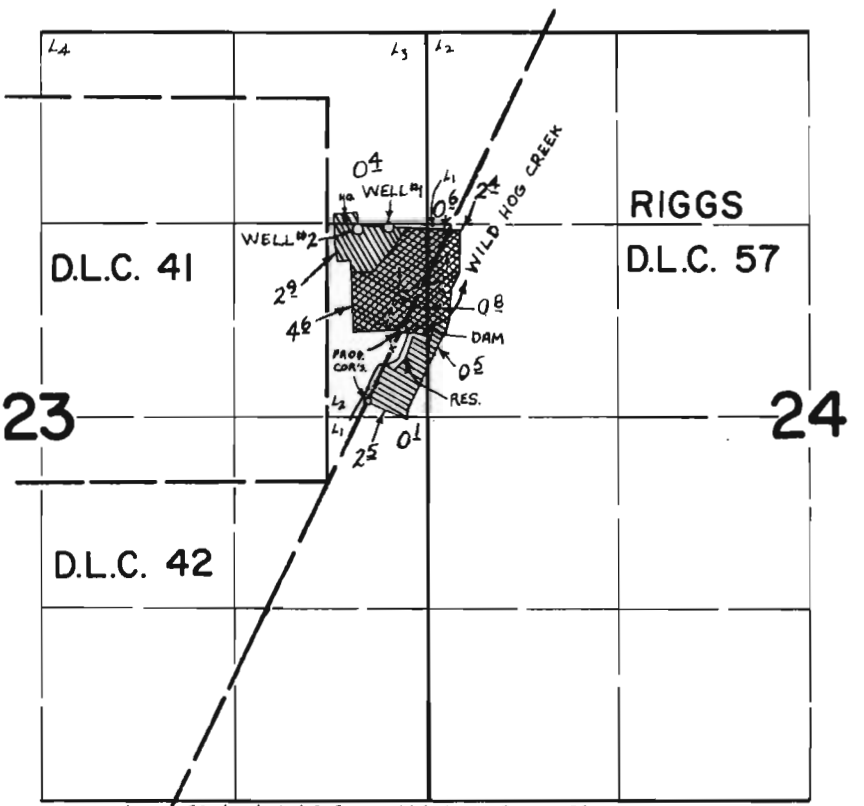

DAM LOC.: 720'S. & 20'E. FROM NE COR LOT 2 SEC. 23.
WELLS LOC.: #1 - 30'S. & 260'W., #2 - 40'S. & 480'W. BOTH FROM NE COR LOT 2 SEC. 23.

PRIMARY FROM WELLS } PERMIT #G-4939
SUPPLEMENTAL FROM WELLS
PRIMARY FROM WILD HOG CR. - PERMIT #35624

FINAL PROOF SURVEY
UNDER
Application No. G-5324 47582 Permit No. G-4939 35624
IN NAME OF
CECIL SAXON
Surveyed JULY 11 1975, by L. TOLL