


T.21S. R.4W. W.M.

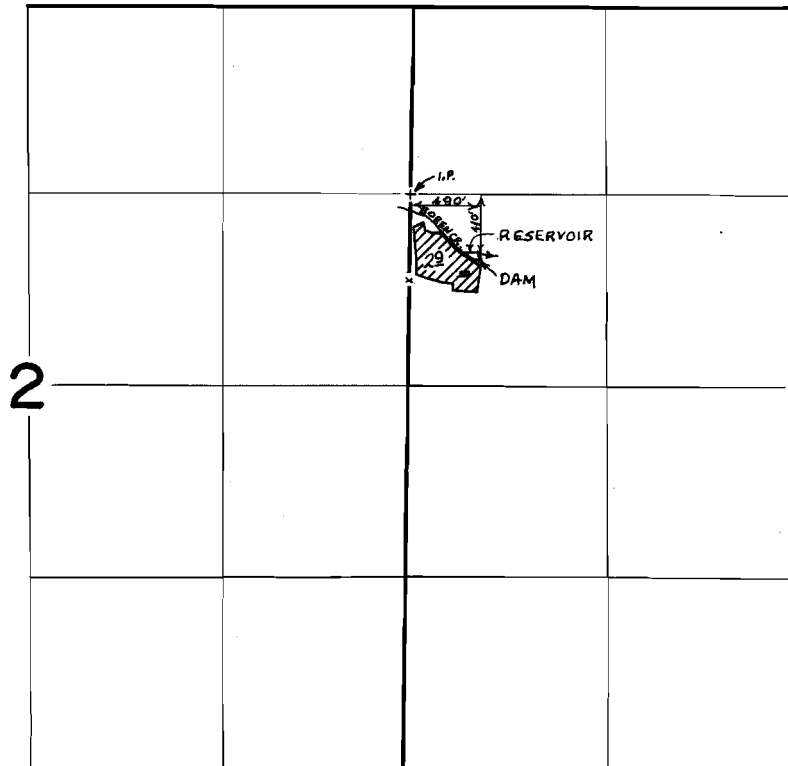

**FINAL PROOF SURVEY**  
UNDER

Application No. 48624 ~~R-49074~~ Permit No. 36475 ~~R-5905~~  
IN NAME OF

JAMES F. HIGGS, JR.

Surveyed AUG. 15 1974, by D. NORBY