


T.16S. R.6W. W. M.

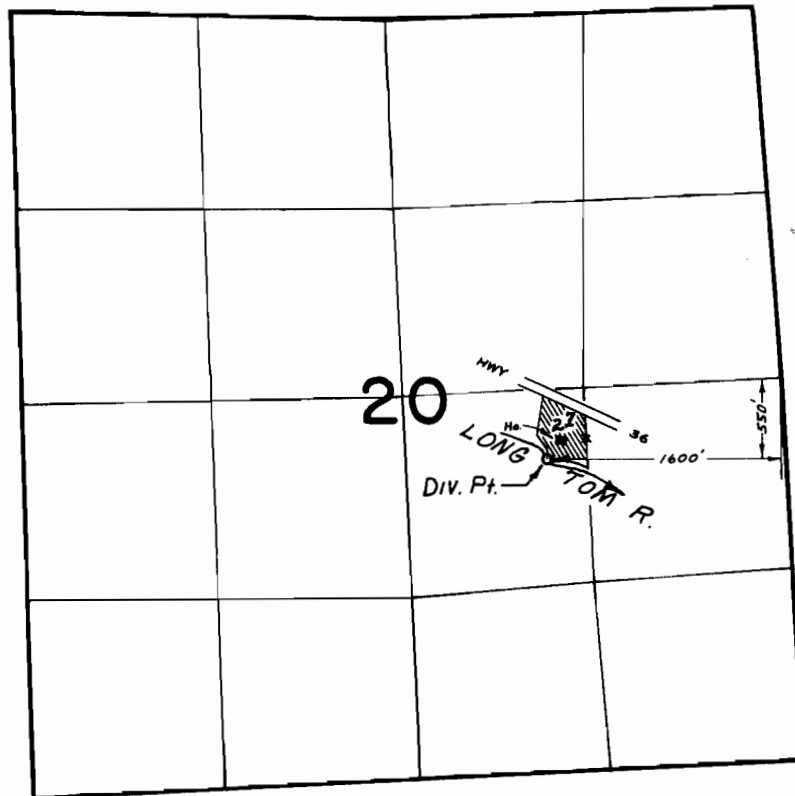

FINAL PROOF SURVEY
UNDER

Application No. 49242 Permit No. 36905
IN NAME OF

JAMES C. AND ANNA E. CAMP

Surveyed APRIL 30, 1975, by R. MUCKEN