


T.12S. R.1 & 2W. W.M. .

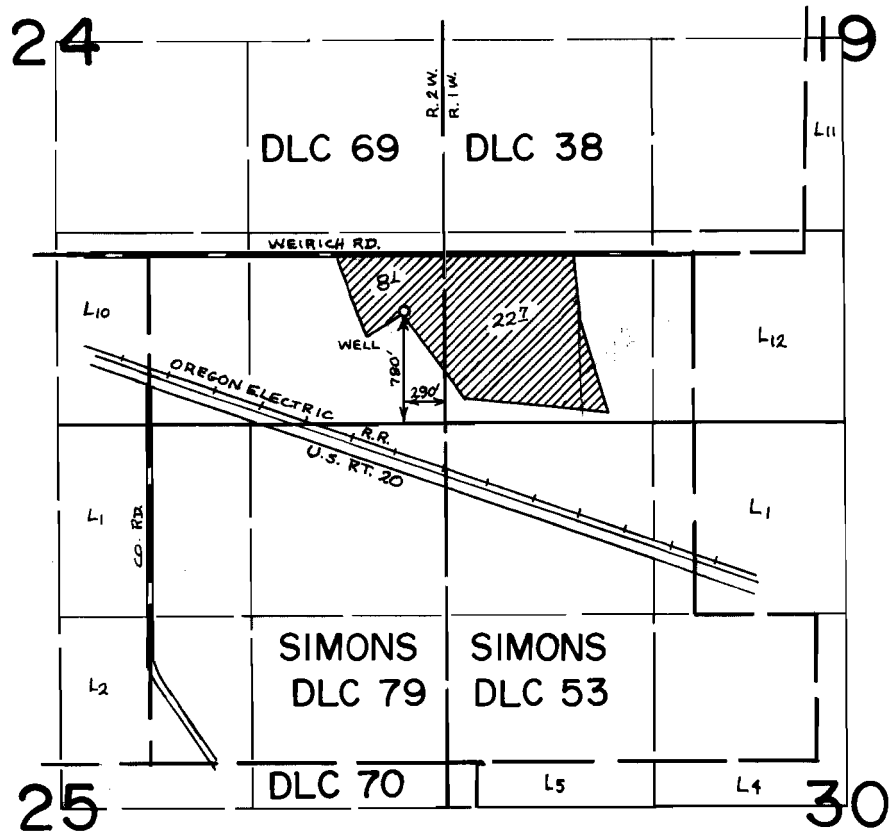

**FINAL PROOF SURVEY**  
UNDER

Application No. G-4773 Permit No. G-4496  
IN NAME OF

ESTATE OF CLARA U. PAPE

Surveyed APR. 3 1974, by S. APPLEGATE