

Form A1-187
March 1961

UNITED STATES
DEPARTMENT OF THE INTERIOR
BUREAU OF LAND MANAGEMENT

SECTION


27

Oregon State Water Filings

TOWNSHIP 38S, RANGE 40E, W. M.

BUCK SPRING
North

RECEIVED
MARCH 1961
STATE ENGINEER
BUREAU OF LAND MANAGEMENT

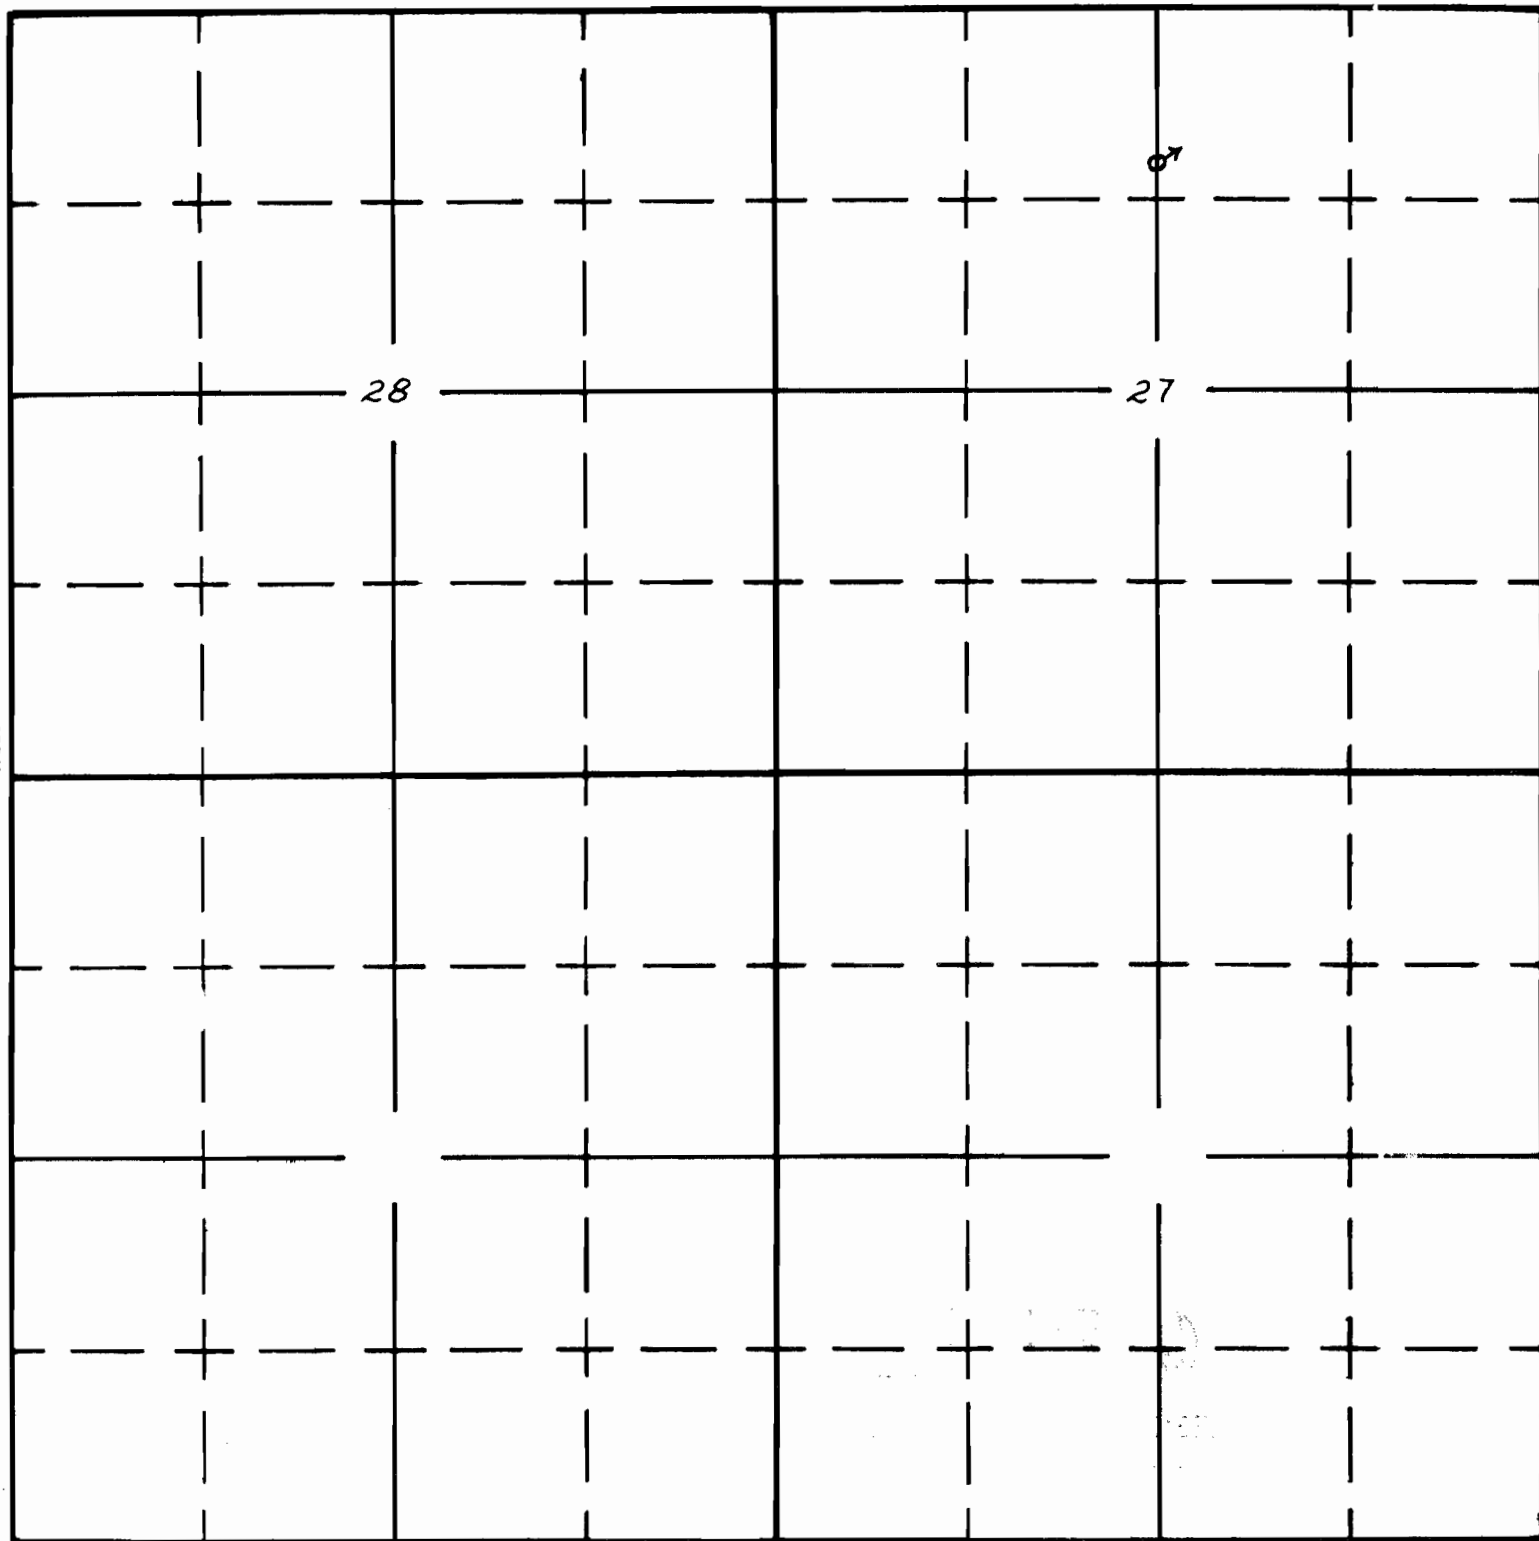

SCALE: 4" = 1 MILE

APPLICATION No. 40980
PERMIT No. 30539