


T.6&7S.,R.2W.,W.M.

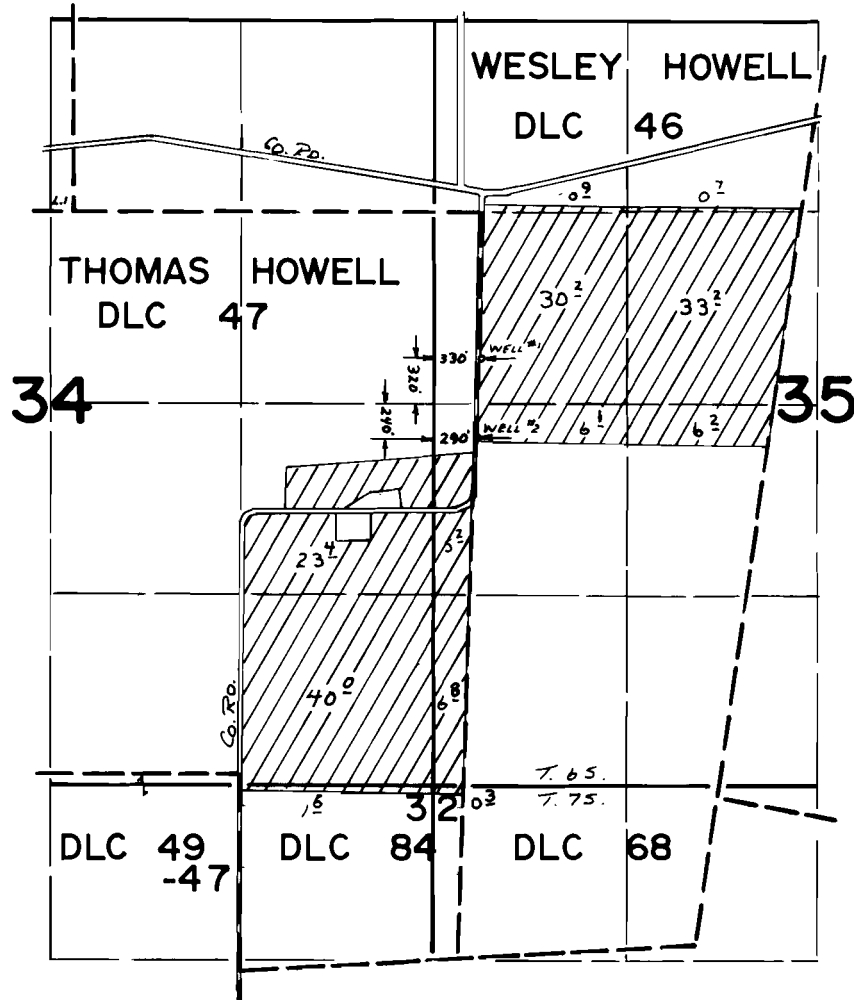

FINAL PROOF SURVEY UNDER

Application No. G-5240 Permit No. G-5042

IN NAME OF
CARL F. JENSEN &
J. B. SOD & SEED

Surveyed SEPT. 3 1974, by L. Toll