


T.8S. R.2W. W.M.

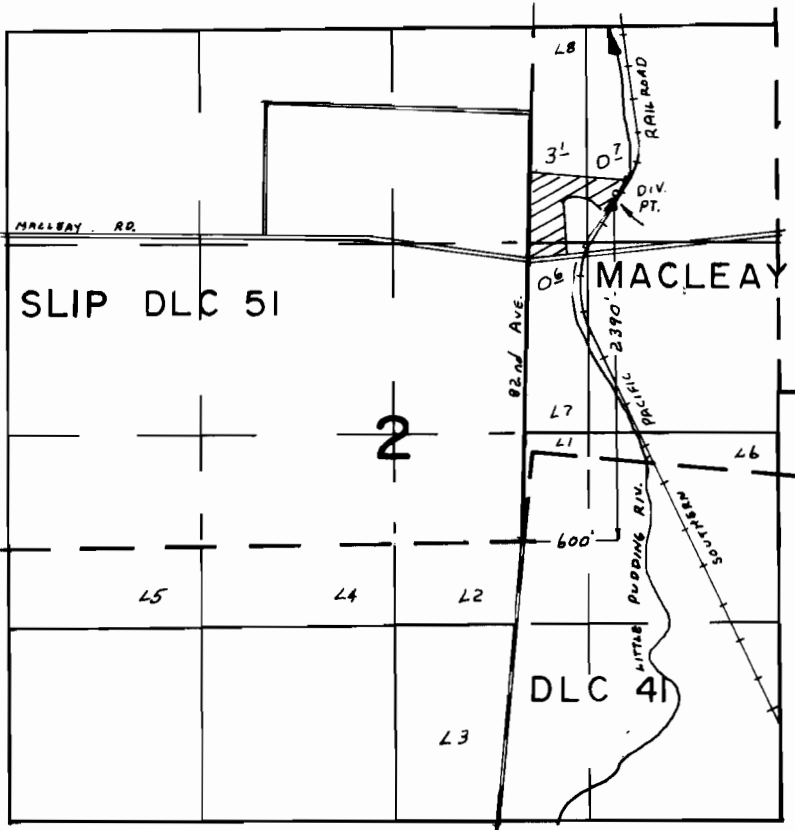

**FINAL PROOF SURVEY**  
UNDER

Application No. 46163 Permit No. 34201  
IN NAME OF

GARY M. & DELORES EMMERSON

Surveyed JUL 5 1974, by L.H. NUNN