


T. 6S. R. 6W. WM

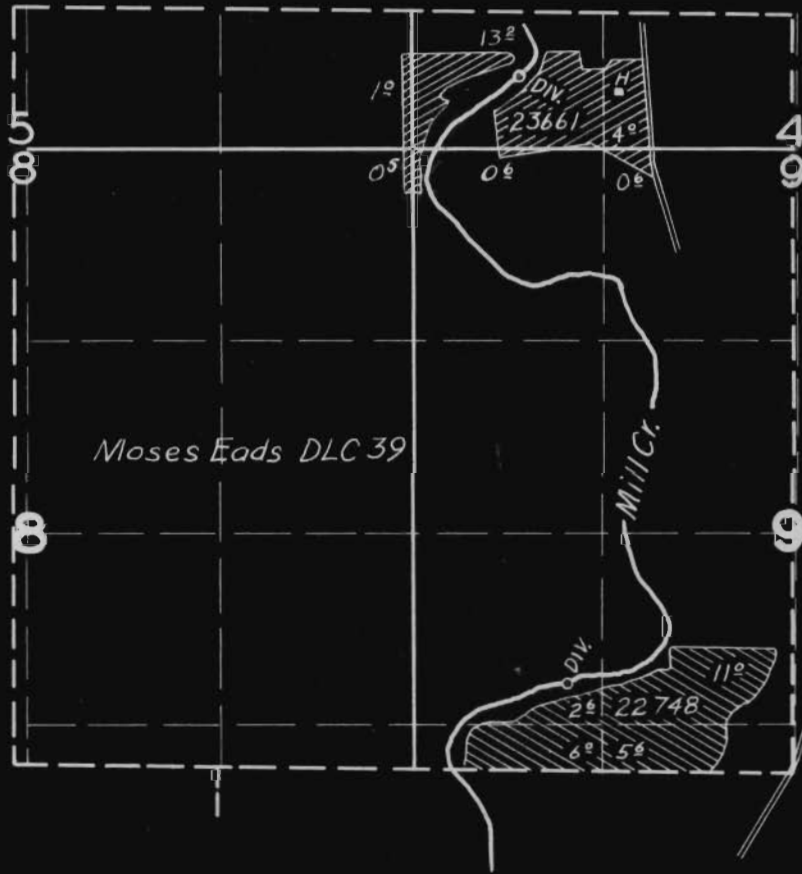

FINAL PROOF SURVEY

UNDER

22748

17935

Application No. 23661 Permit No. 18805

IN NAME OF

Hugh Veach

W. H. Hibbert

Surveyed July 12 19 54, by T. Jones