


T.6 S. R.6 W.W.M.

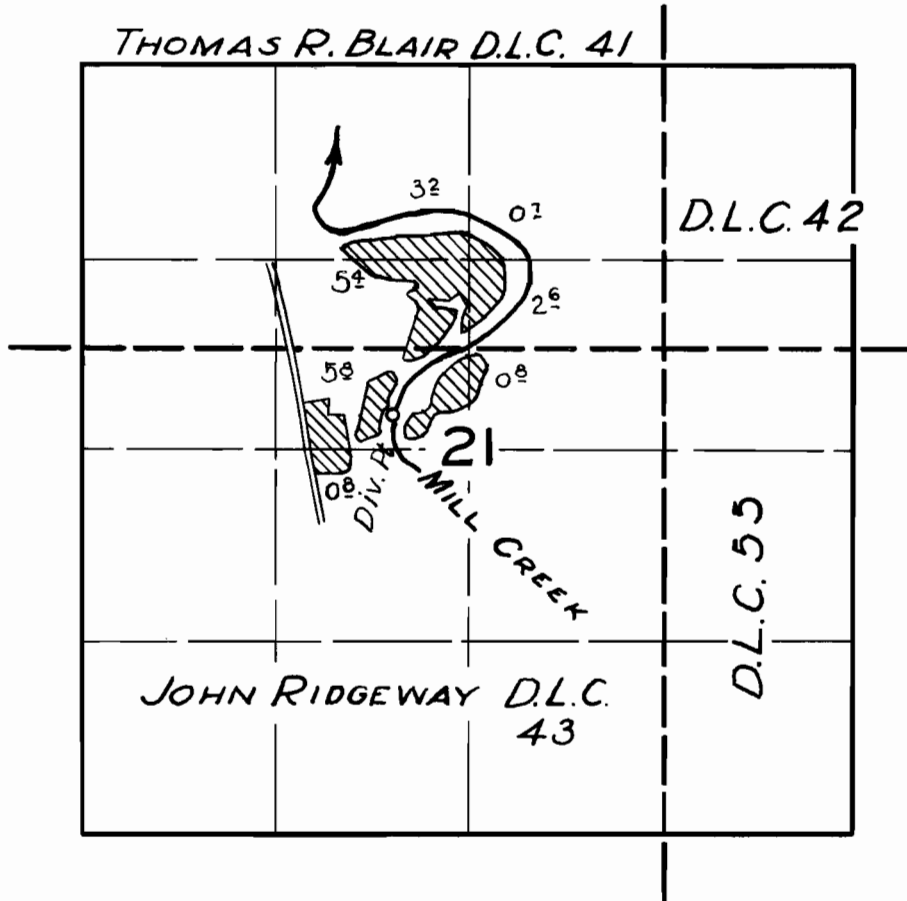

FINAL PROOF SURVEY
UNDER

Application No. 28215 Permit No. 22201
IN NAME OF

William P. Harris

Surveyed April 7, 1958, by R.H. Whitby