


T.4 S., R.10 W., W.M.

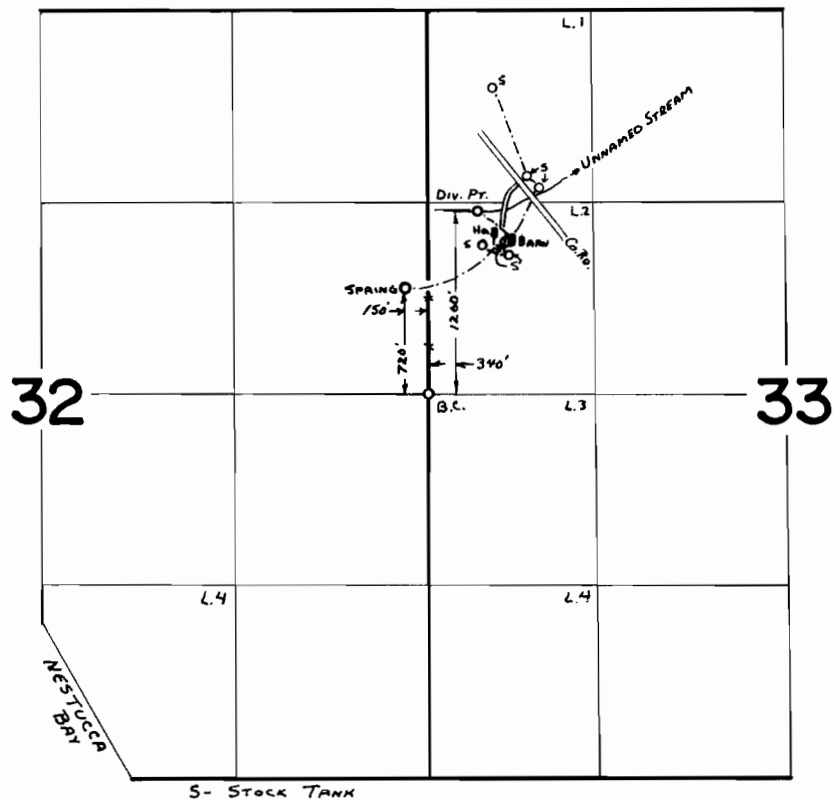

FINAL PROOF SURVEY
UNDER

Application No. 41260 Permit No. 30885
IN NAME OF

VICTOR C. KELLY

Surveyed JUNE 28 1974, by L. T. TOLL