T. 3 S., R. 10 W., W.M.

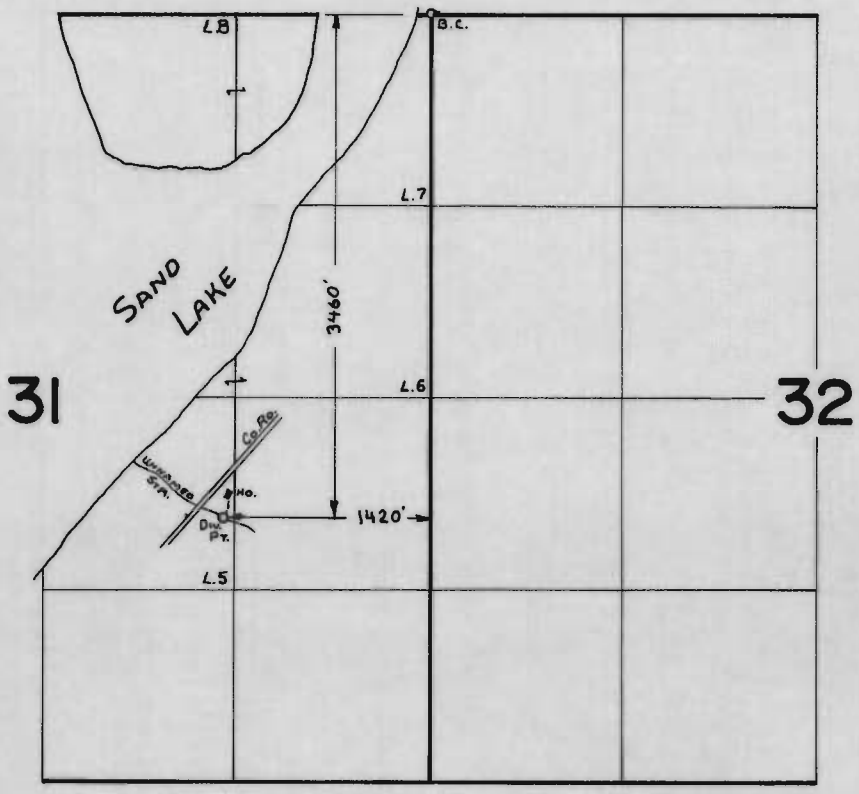

FINAL PROOF SURVEY
UNDER

Application No. 47641 Permit No. 35654
IN NAME OF

EDVIN OHMAN & ANNA OHMAN

Surveyed Aug. 29 1974, by L. Toll

PTS 1974-V