


T. 4 N. R. 28 E. W. M.

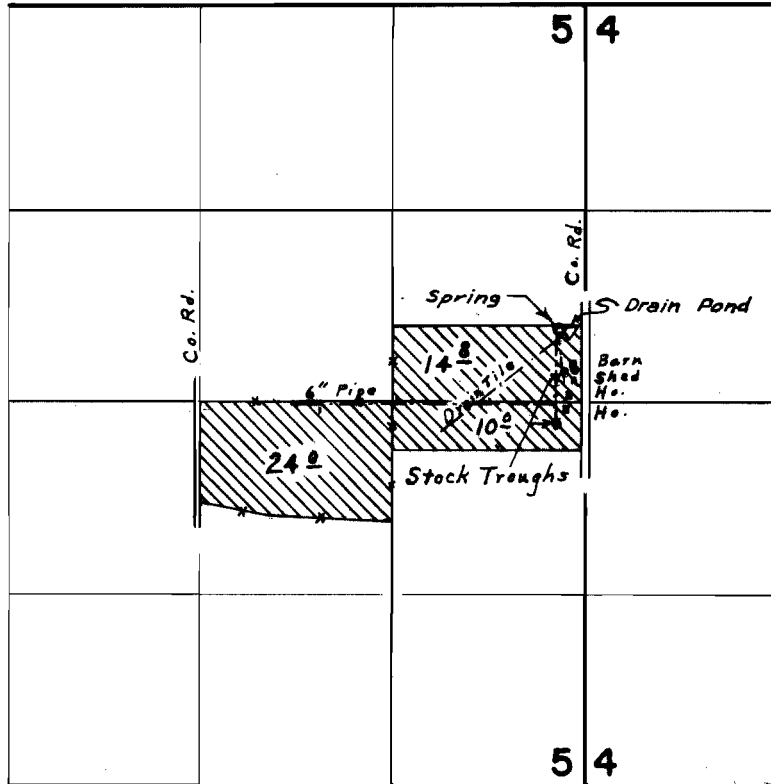

Div. Pts. located: Spr., 510' N. & 1140' E., Drain, 470' N. & 1180' E. both from S.W. Cor. S. E. & N. E. $\frac{1}{4}$ Sec. 5

FINAL PROOF SURVEY UNDER

Application No. 42026 Permit No. 31390

IN NAME OF

SYLVIA L. McAHREN &

THE ESTATE OF ELWIN S. McAHREN

JUNE 22, 1971,

Surveyed APRIL 17, 1973, by L. E. Gould