


E-147
PA ~~115~~

T.1&2S.R.13E.W.M.

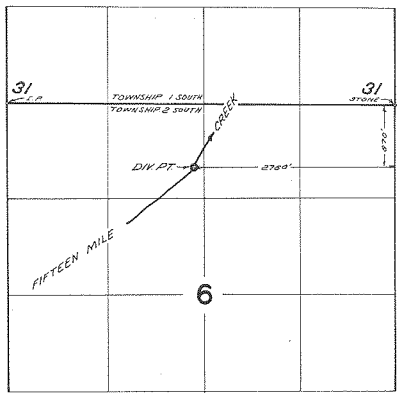

FINAL PROOF SURVEY UNDER

TRANSFER No. C-175
Application No. Permit No.
IN NAME OF
CARL CASEY
Surveyed Nov. 14, 1967, by W. J. RUPPERT