


T.4S., R.7W., W.M.

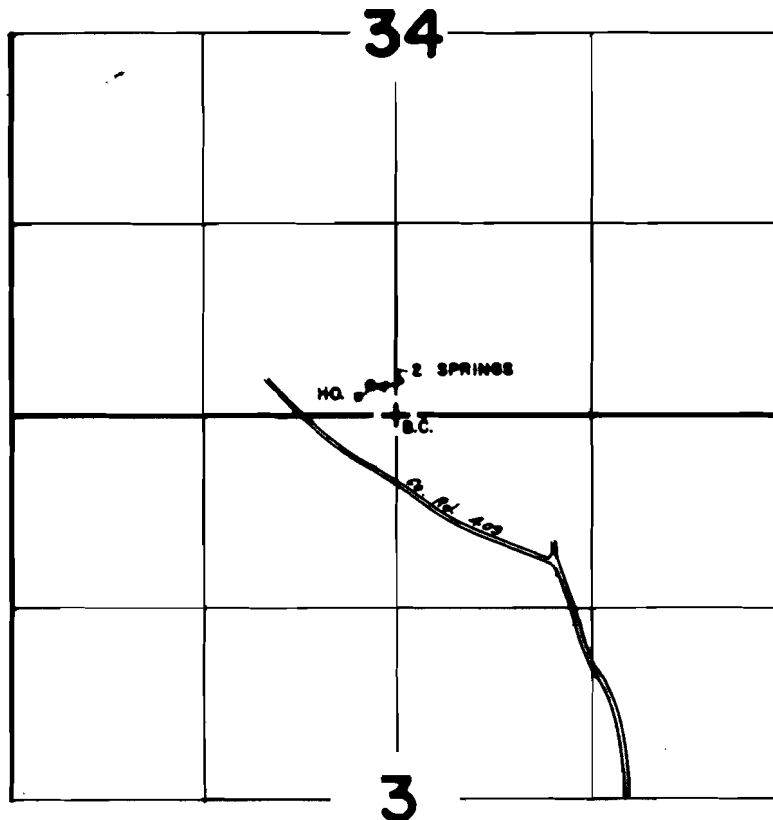

SPRING 1 LOC.: 200' N & 170' W. FROM S. 1/4 COR. SEC. 34
SPRING 2 LOC.: 210' N & 170' W. FROM S. 1/4 COR. SEC. 34

FINAL PROOF SURVEY
UNDER

Application No. 41770 Permit No. 31179
IN NAME OF

STEPHEN O. NELSON

Surveyed MAY 13, 1976, by L.H. NUNN