


T. 2 S. R. 3 W. W. M.

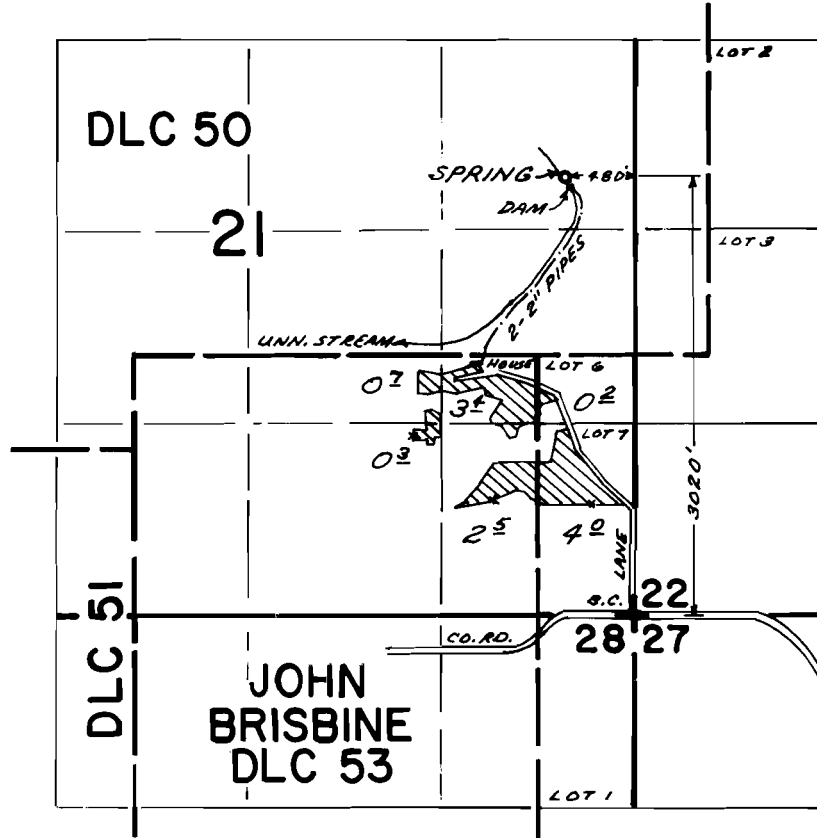

**FINAL PROOF SURVEY**  
UNDER

Application No. 45970 Permit No. 34341  
IN NAME OF

**ROBERT H. HILL**

Surveyed Oct. 22 1976, by D. BUELL