


T.36S.,R.3W.,W.M.

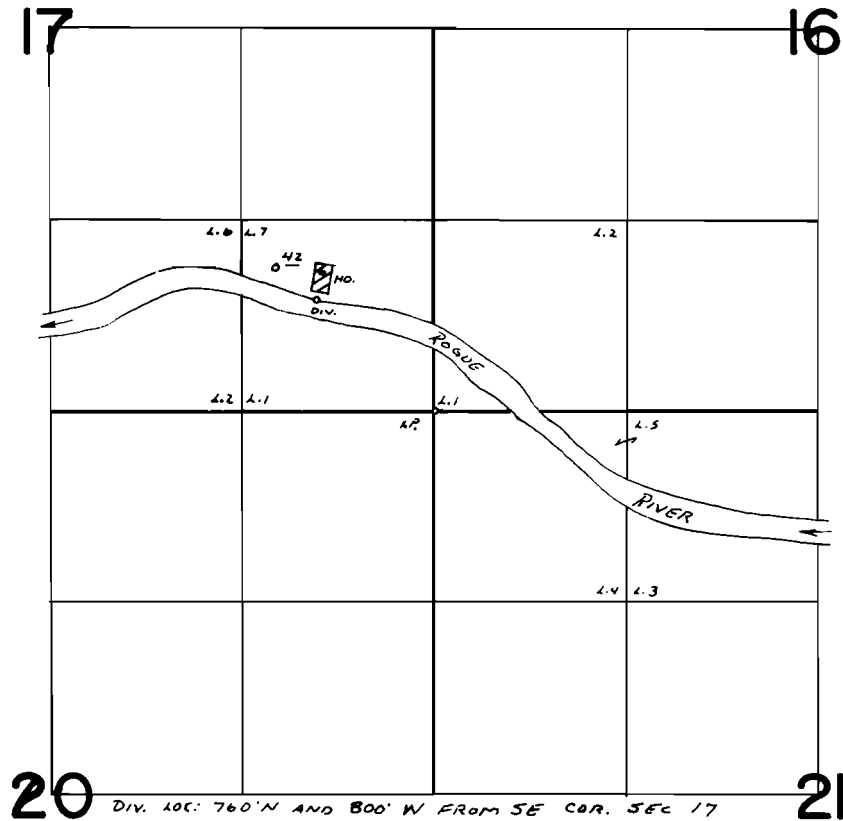

FINAL PROOF SURVEY
UNDER

Transfer No. 2771
Application No. Permit No.
IN NAME OF

RAYMOND P. & ALYCE B. CRISS

Surveyed Aug. 14, 1975, by L. E. Gould