


T.8S. R.39E. W.M.

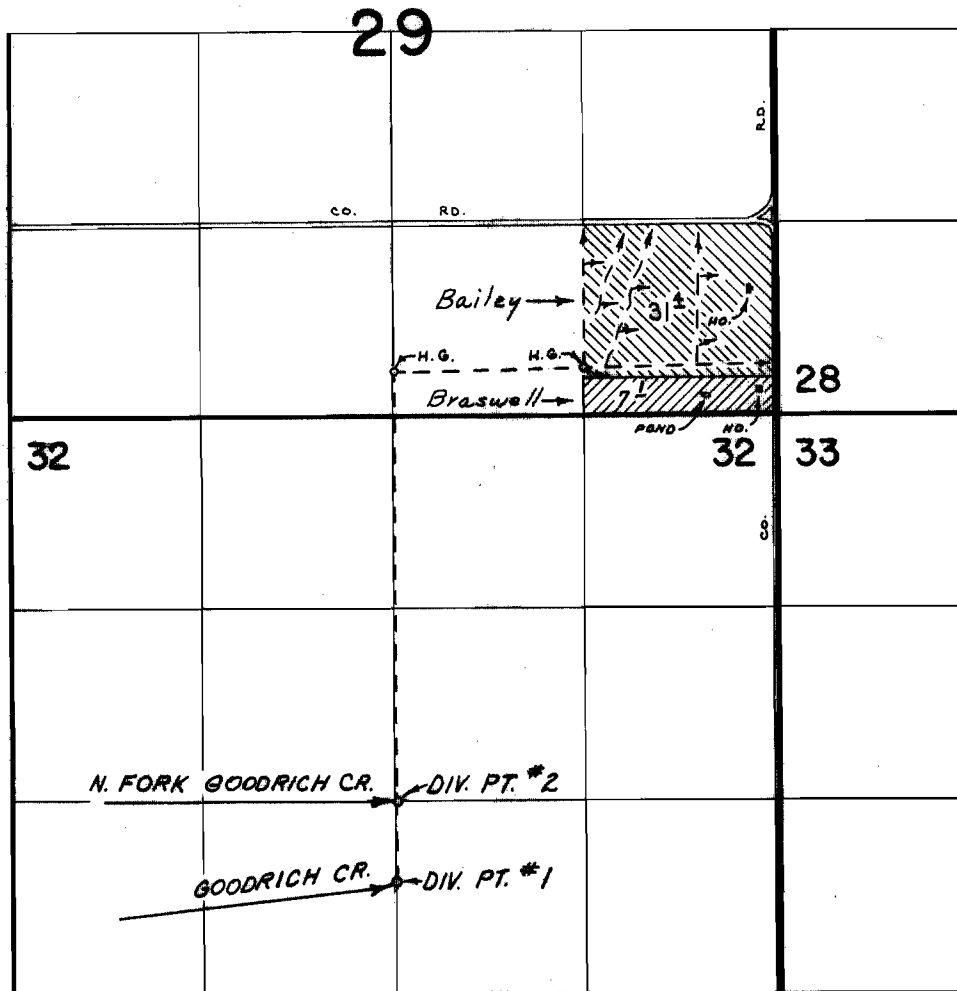

DIV. PTS. LOC: NO. 2 - 2640' S. & 2620' W., NO. 1 - 3200' S. & 2620' W., BOTH FROM NE CORNER SECTION 32.

FINAL PROOF SURVEY
UNDER

Application No. 43859 Permit No. 32773
IN NAME OF

V. H. BAILEY

Surveyed AUG. 19, 1975, by R. MUCKEN