


T.15S., R.5W., W.M.

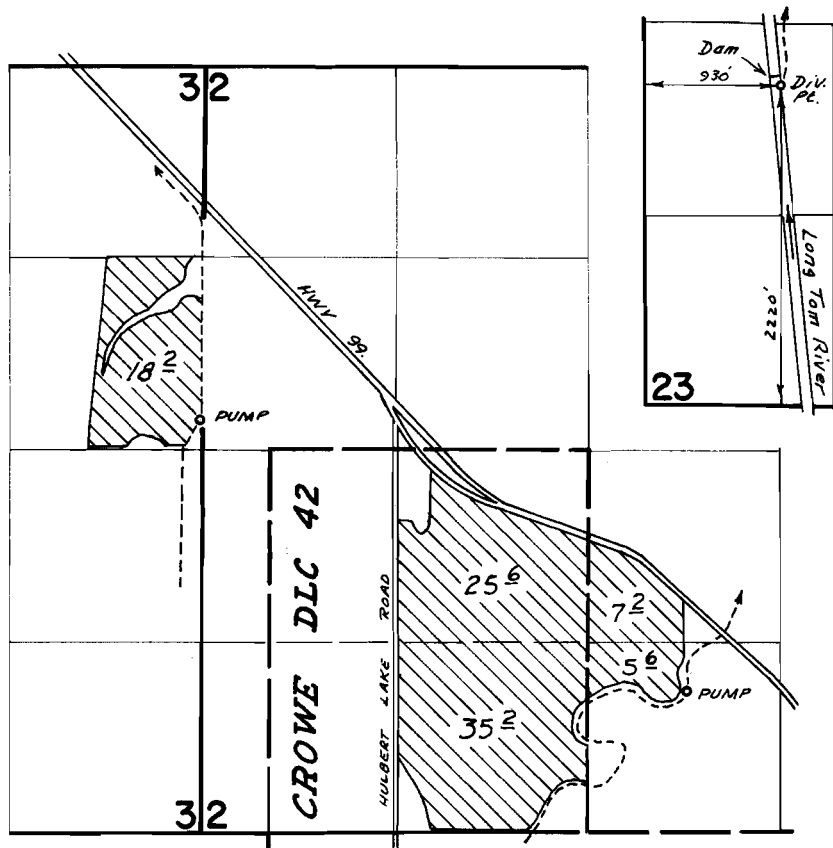

FINAL PROOF SURVEY
UNDER

Application No. 44568 Permit No. 33359
IN NAME OF

LESLIE C. KIRKHAM

Surveyed April 23, 1975, by D. Norby