


T.13S., R.5W., W.M.

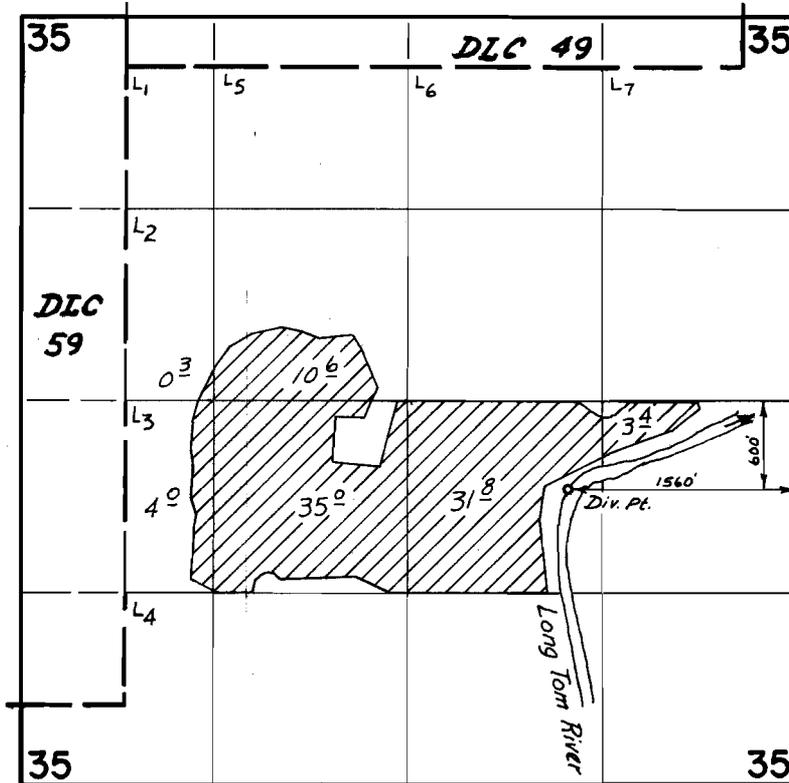

FINAL PROOF SURVEY
UNDER

Application No. 48480 Permit No. 36420
IN NAME OF

R. F. RICKARD

Surveyed Aug. 6, 1975, by D. Norby