


# T.4S.R.1E.W.M.

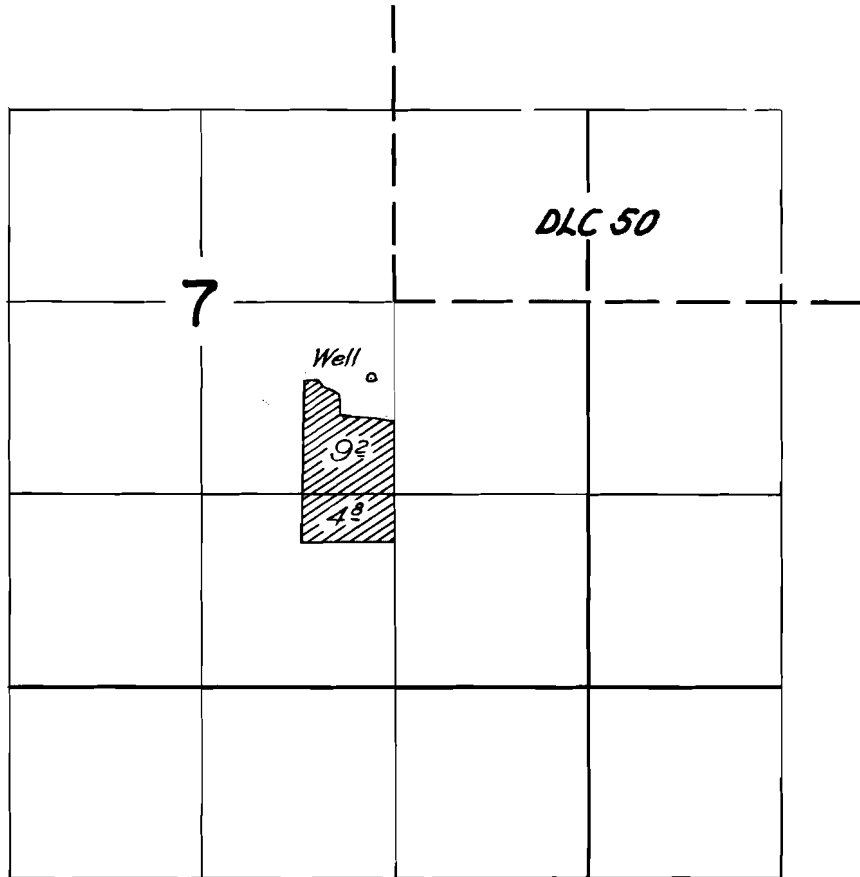

## FINAL PROOF SURVEY UNDER

Application No. *G-1975* Permit No. *G-1811*  
IN NAME OF

*Joseph N. Hershberger*

Surveyed *June 22*, 1962, by *Thomas F. Lauer*