


T.2 S. R.4 E. W.M.

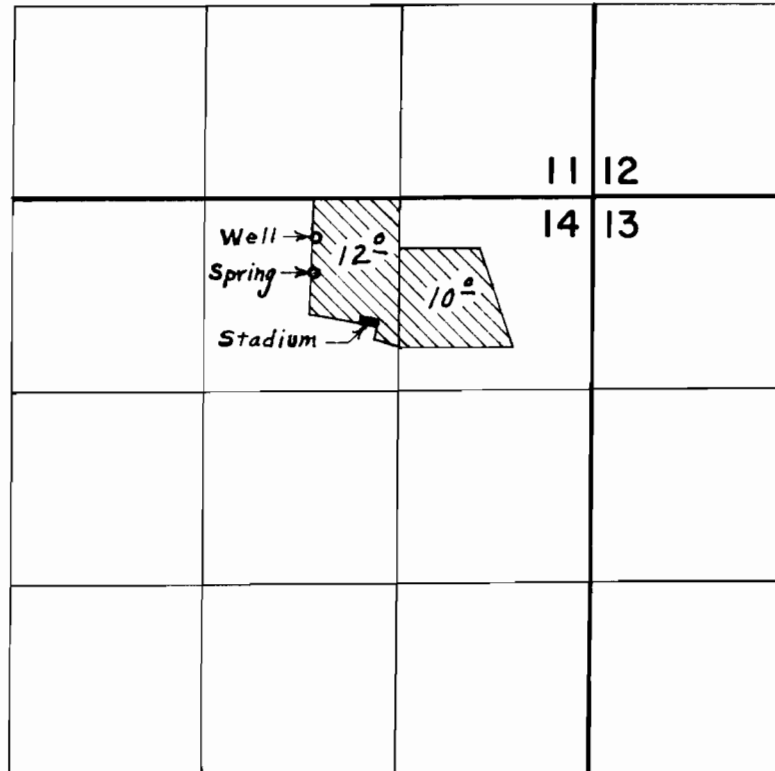

Div. Pts. located: Well, 270' S. & 1890' W.; Spring, 520' S. & 1900' W. from N.E. Cor. Section 14

FINAL PROOF SURVEY

UNDER

Application No. G-3673 42809 Permit No. G-3351 32004

IN NAME OF

SANDY UNION HIGH SCHOOL

Surveyed Aug. 29, 1975, by L. E. Gould