





T.2S. R.4E. W.M.

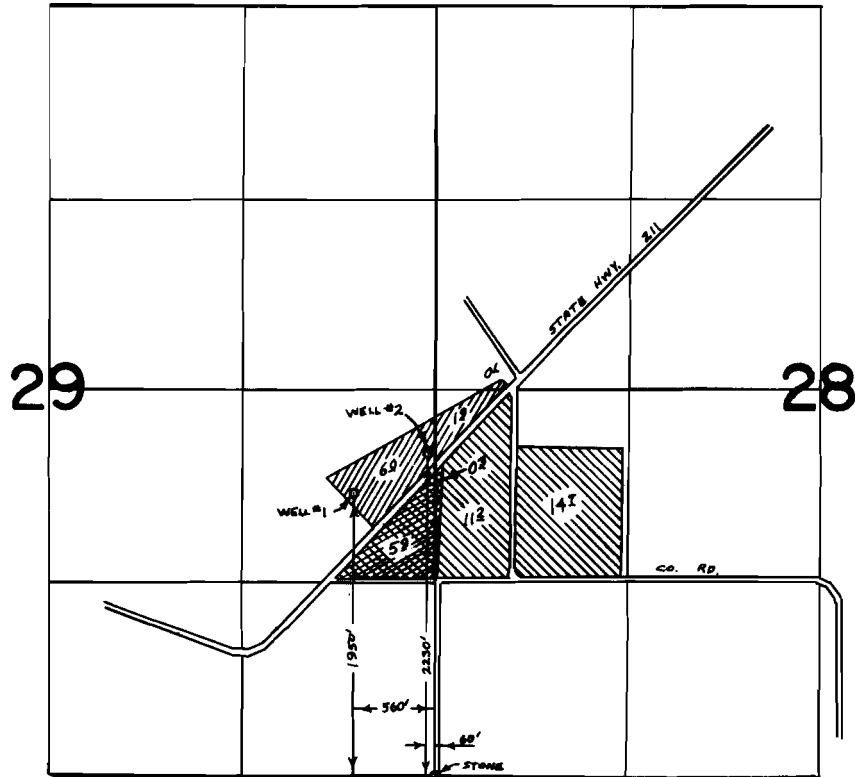

-  SUPPLEMENTAL FROM WELL #1
-  PRIMARY FROM WELL #2
-  SUPPLEMENTAL FROM WELL #2

FINAL PROOF SURVEY UNDER

Application No. G-4256 Permit No. G-4011
IN NAME OF

VIRGIL W. NELSON

Surveyed OCT. 24 1975, by L. TOLL