


T.1 & 2 S. R.3 E. W.M.

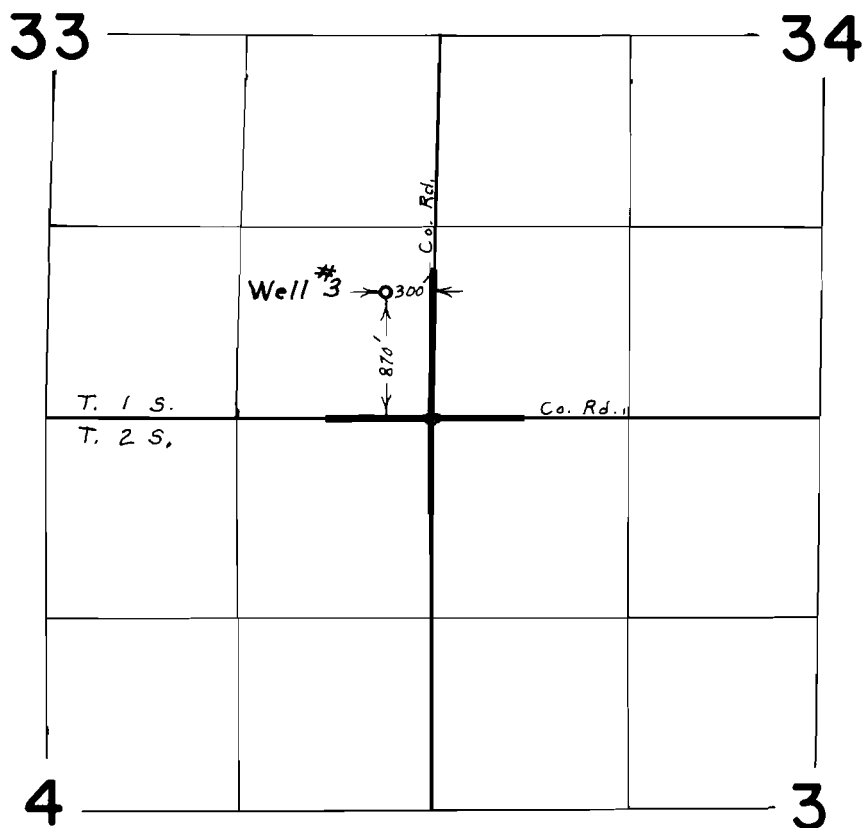

FINAL PROOF SURVEY
UNDER

Application No. G-5602 Permit No. G-5008
IN NAME OF

DAMASCUS WATER DISTRICT

Surveyed Aug. 29, 1975, by L. E. Gould