




T.3S. R.3 & 4 E. W.M.

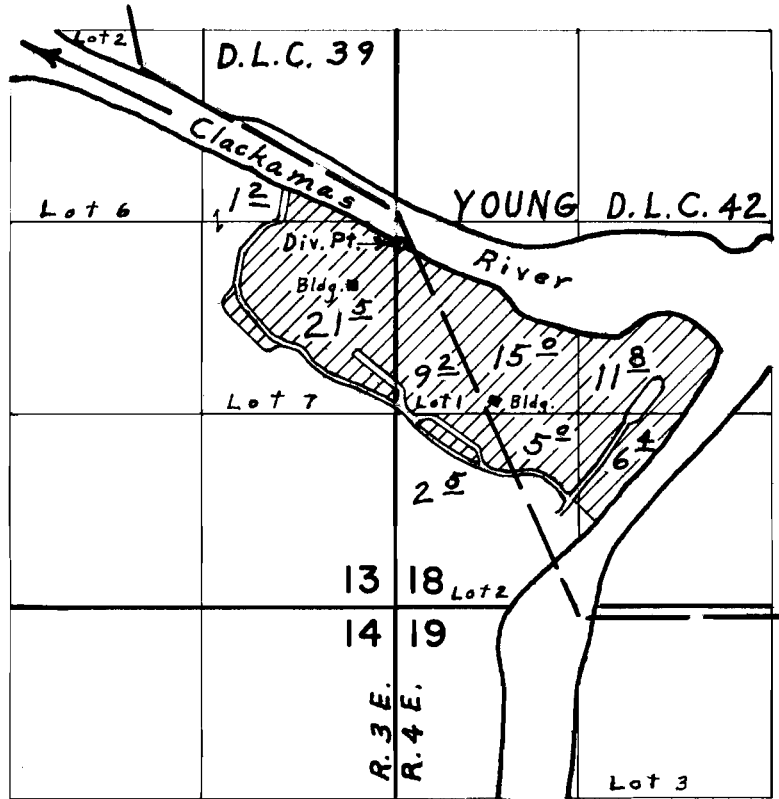

Div. Pt. located 2490' N. & 40' E. from S.W. Cor. Sec. 18

FINAL PROOF SURVEY

UNDER

Application No. 44003 Permit No. 32895

IN NAME OF

OREGON STATE PARKS

Surveyed May 30, 1975, by L. E. Gould