


T.5 S. R.2 E. W.M.

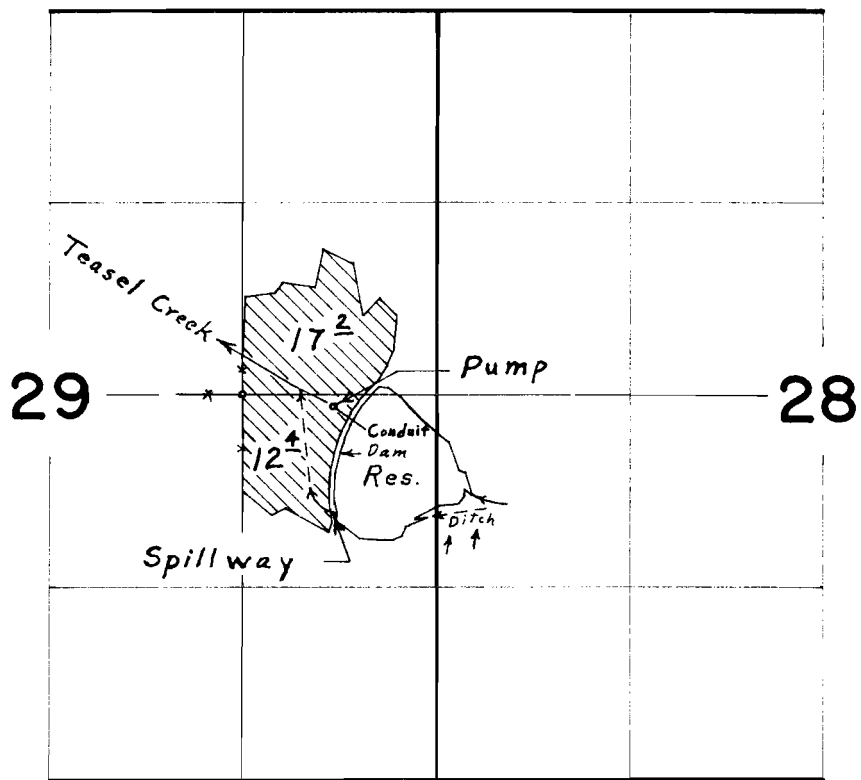

Div. Pt. located 170' S. & 750' E. from N.W. Cor. N.E. $\frac{1}{4}$ S.E. $\frac{1}{4}$ Sec. 29

FINAL PLAT SURVEY

UNDER

R-45734

R-5377

Application No. 45735

Tract No. 33950

IN NAME OF

WILLARD DEARDORFF

Surveyed May 28, 1975, by L. E. Gould