


T.3 S. R.2 E. W.M.

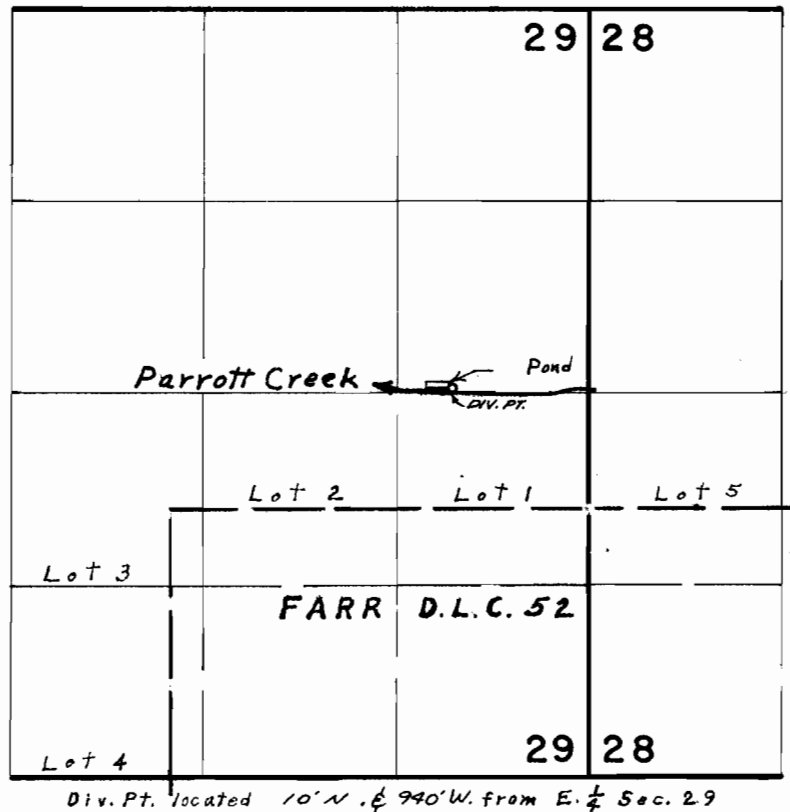

FINAL PROOF SURVEY

UNDER

R-47655 R-5740
Application No. ~~47656~~ Permit No. ~~35658~~

IN NAME OF

C. V. SMIDT

Surveyed May 7, 1975, by L. E. Gould