


T.28S. R.12&13W. W.M.

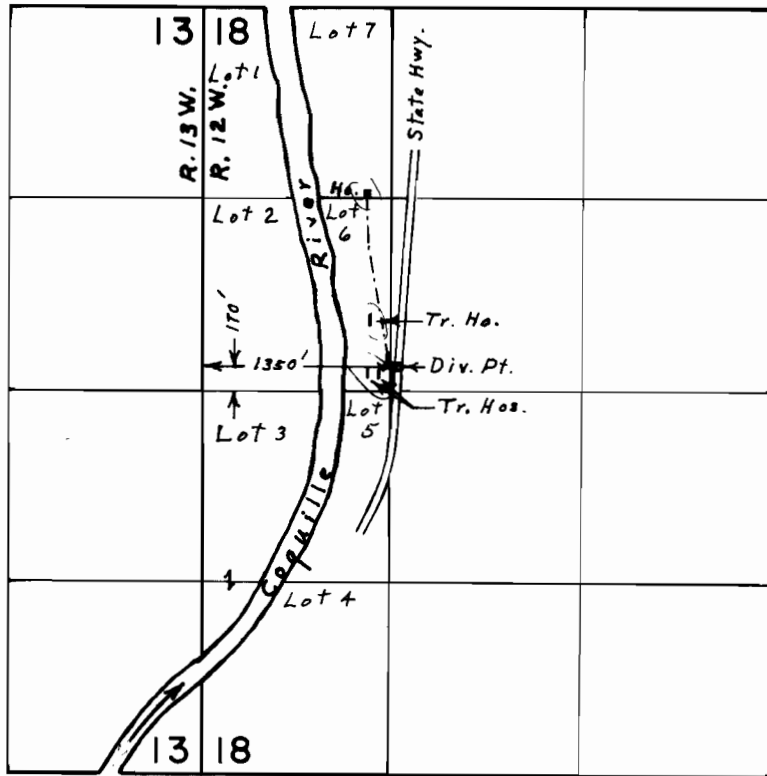

FINAL PROOF SURVEY
UNDER

Application No. 46910 Permit No. 35094
IN NAME OF

T. A. McNAIR

Surveyed Oct. 27, 1975, by L. E. Gould