


T.28S. R.12W. W.M.

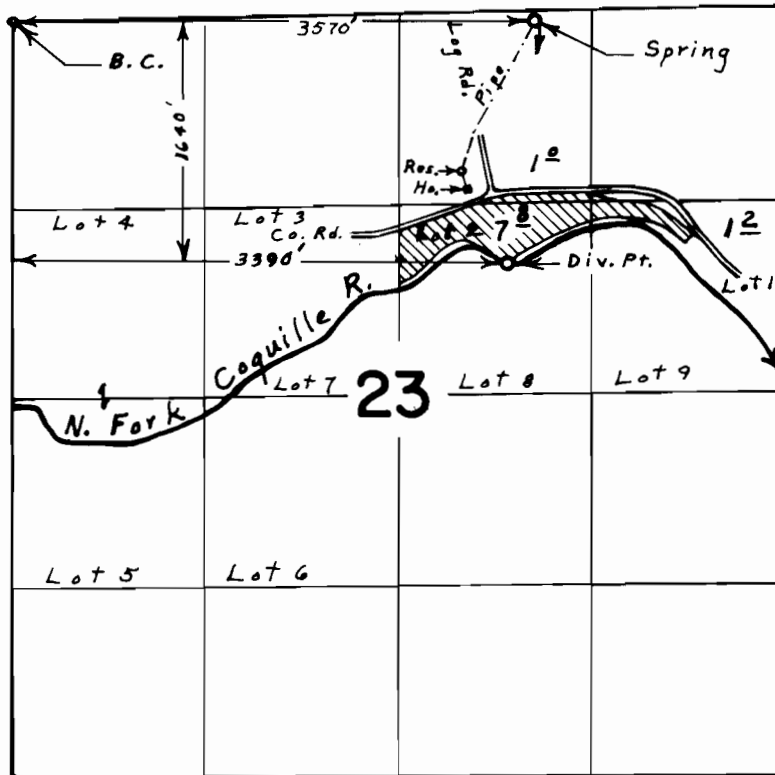

FINAL PROOF SURVEY
UNDER

Application No. 47714 Permit No. 35743
IN NAME OF

AGNES E. JENSEN

Surveyed Oct. 27, 1975, by L. E. Gould