


T.27S., R.11W., W.M.

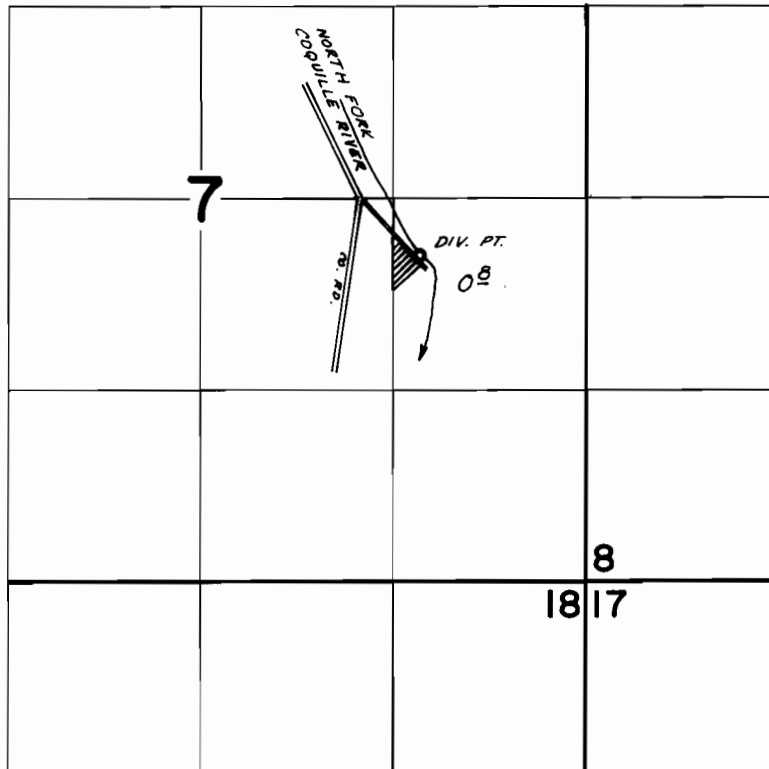

DIV. PT. LOC: 390' S & 190' E FROM NW COR. NE $\frac{1}{4}$ SE $\frac{1}{4}$ SEC 7

FINAL PROOF SURVEY
UNDER

Application No. 48090 Permit No. 36114
IN NAME OF

.....
Surveyed July 15 1976, by D. Norby