


T.28 S. R.13 & 14 W. W.M.

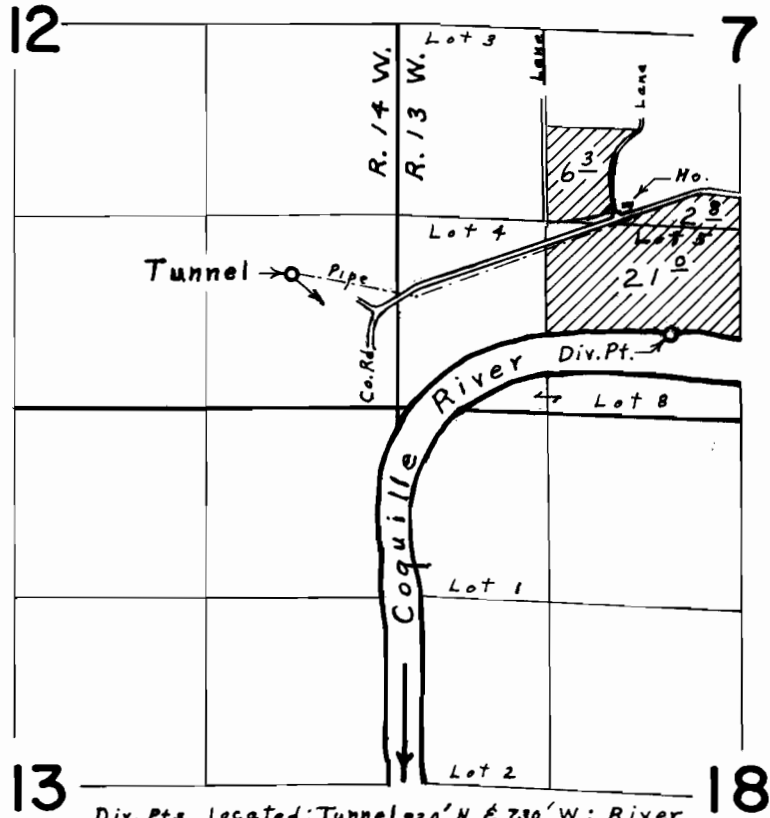

Div. Pts. located: Tunnel, 920' N. & 730' W.; River, 490' N. & 1680' E., both from S. W. Cor. Sec. 7

**FINAL PROOF SURVEY**  
UNDER

Application No. 48147 48259 Permit No. 36177 36235  
IN NAME OF

CALVIN A. PEARCE

Surveyed Oct. 22, 1975, by L. E. Gould