


T.28S. R.13W. W.M.

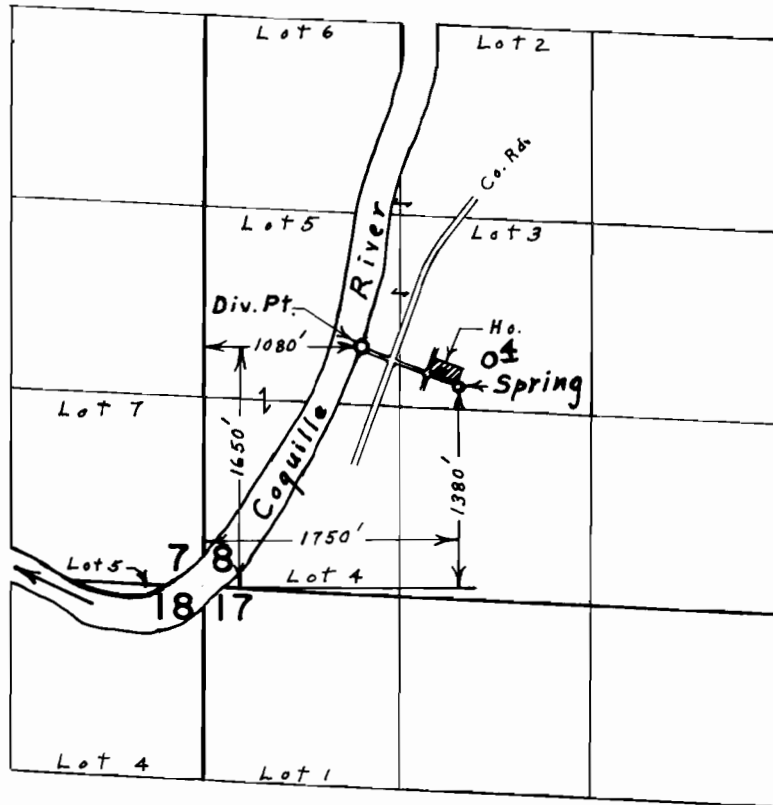

FINAL PROOF SURVEY
UNDER

Application No. 48870 Permit No. 36719
IN NAME OF

LAWRENCE A. DORLAND

Surveyed Oct. 22, 1975, by L. E. Gould