


T.25S., R.12W., W.M.

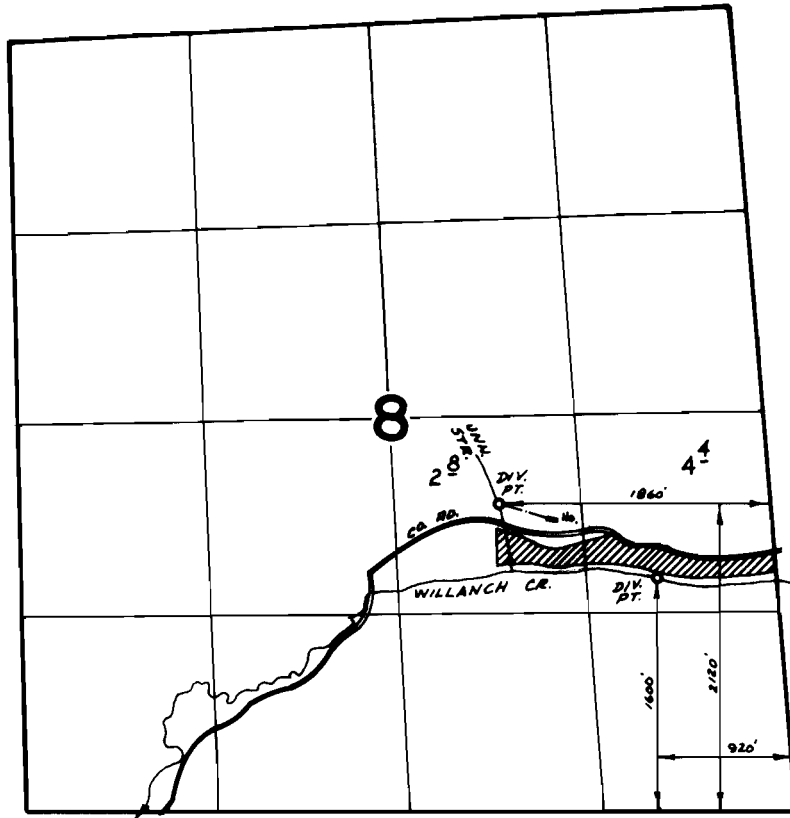

FINAL PROOF SURVEY
UNDER

Application No. ~~49672~~ **49673** Permit No. ~~37191~~ **37192**
IN NAME OF

DR. RICHARD WEST

Surveyed **Sept. 22, 1975**, by **D. Norby**