


T.29 S. R.12W. W.M.

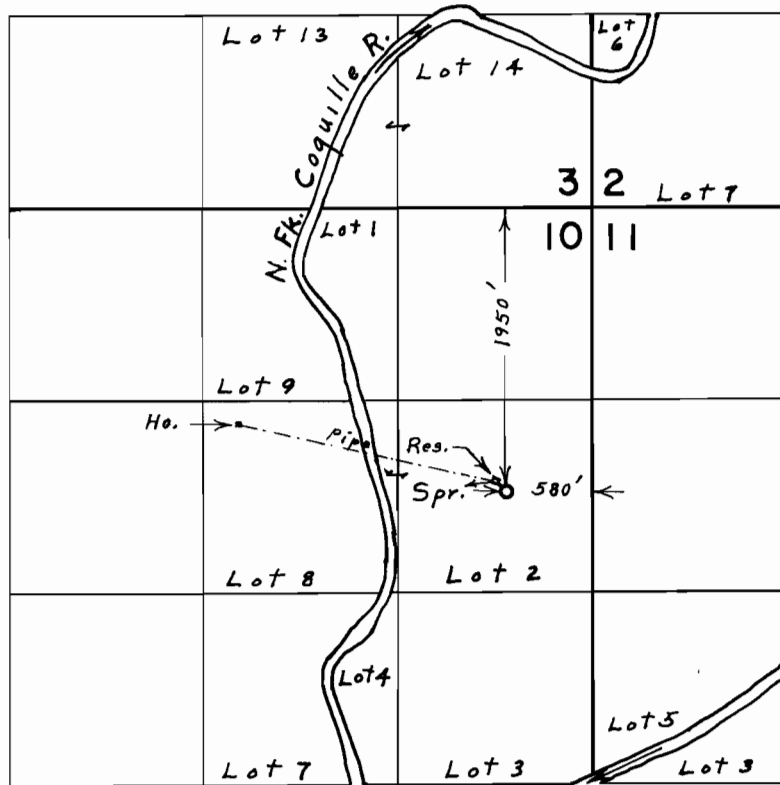

FINAL PROOF SURVEY
UNDER

Application No. 49762 Permit No. 37258
IN NAME OF

CATHERINE W. HUNTLEY

Surveyed Oct. 29, 1975, by L. E. Gould