


T.25S., R.11W., W.M.

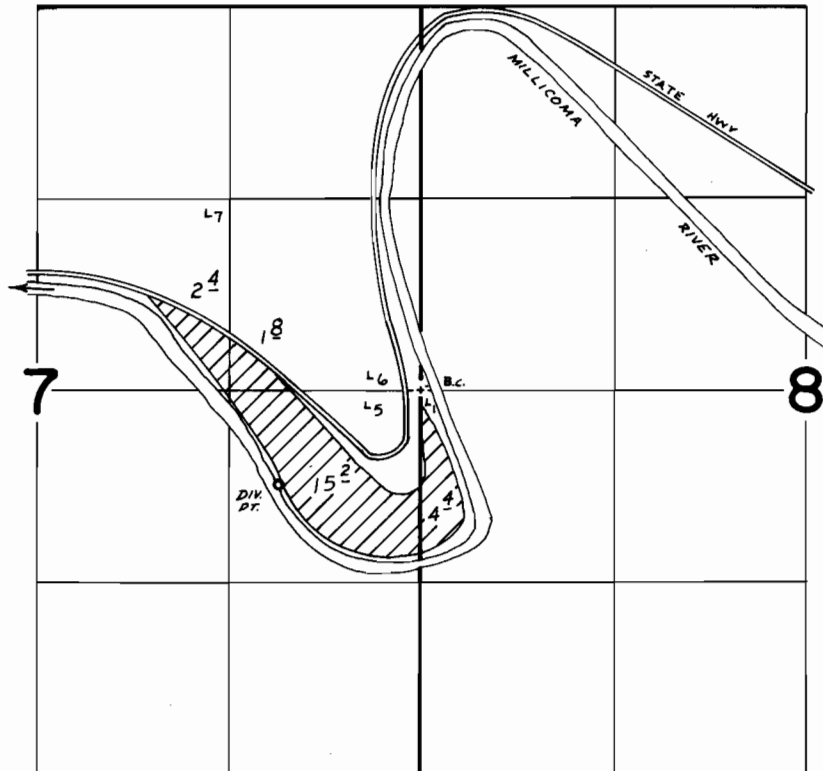

DIK. PT. LOC: 640' S & 970' W FROM E 1/4 COR. SEC. 7

FINAL PROOF SURVEY UNDER

Application No. 50391 Permit No. 37315
IN NAME OF

LEONARD L. ROOD

Surveyed Sept. 18 1975, by D. Norby