


T.27S. R.12W. W.M.

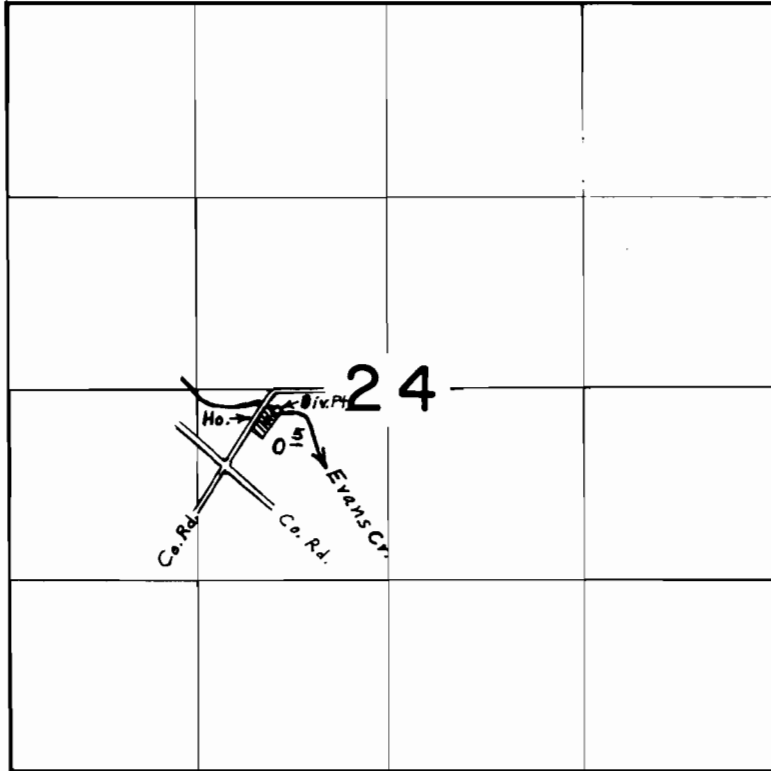

Div. Pt. located 130' S. & 750' W. from Center Sec. 24

FINAL PROOF SURVEY
UNDER

Application No. 49990 Permit No. 37597
IN NAME OF

CLYDE V. CHRISTY

Surveyed Oct. 25, 1975, by L. E. Gould