


T.29S. R.13W. W.M.

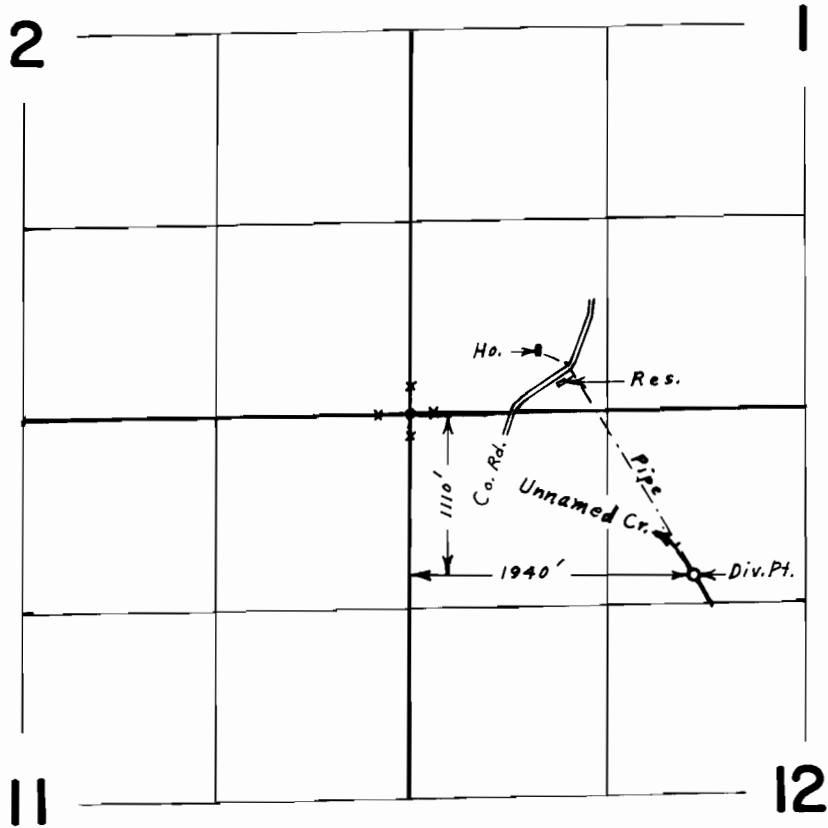

FINAL PROOF SURVEY
UNDER

Application No. 51942 Permit No. 37719
IN NAME OF

RONALD E. DOYLE

Surveyed Oct. 23, 1975, by L. E. Gould