
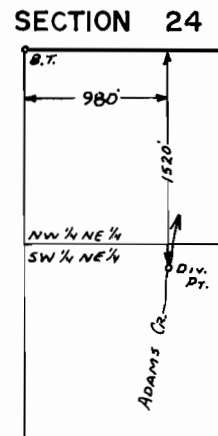


T.23S.,R.5W.,W.M.

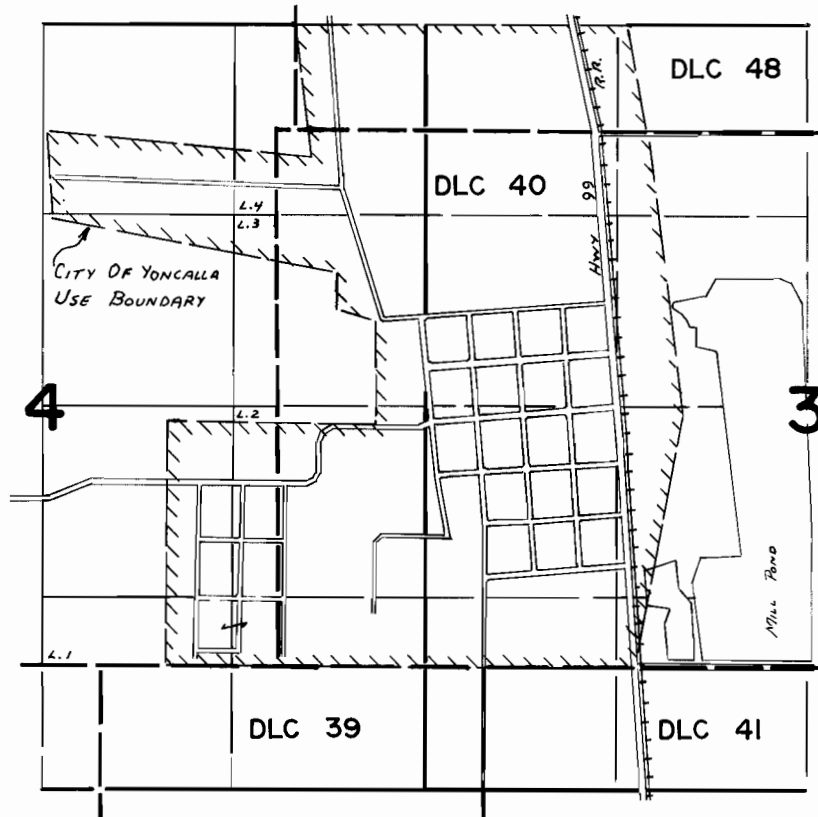

FINAL PROOF SURVEY
UNDER

Application No. 18655 Permit No. 14287
IN NAME OF

CITY OF YONCALLA

Surveyed JUNE 4, 1975, by L. E. GOULD