


# T.25 S.R.5 W.W.M.

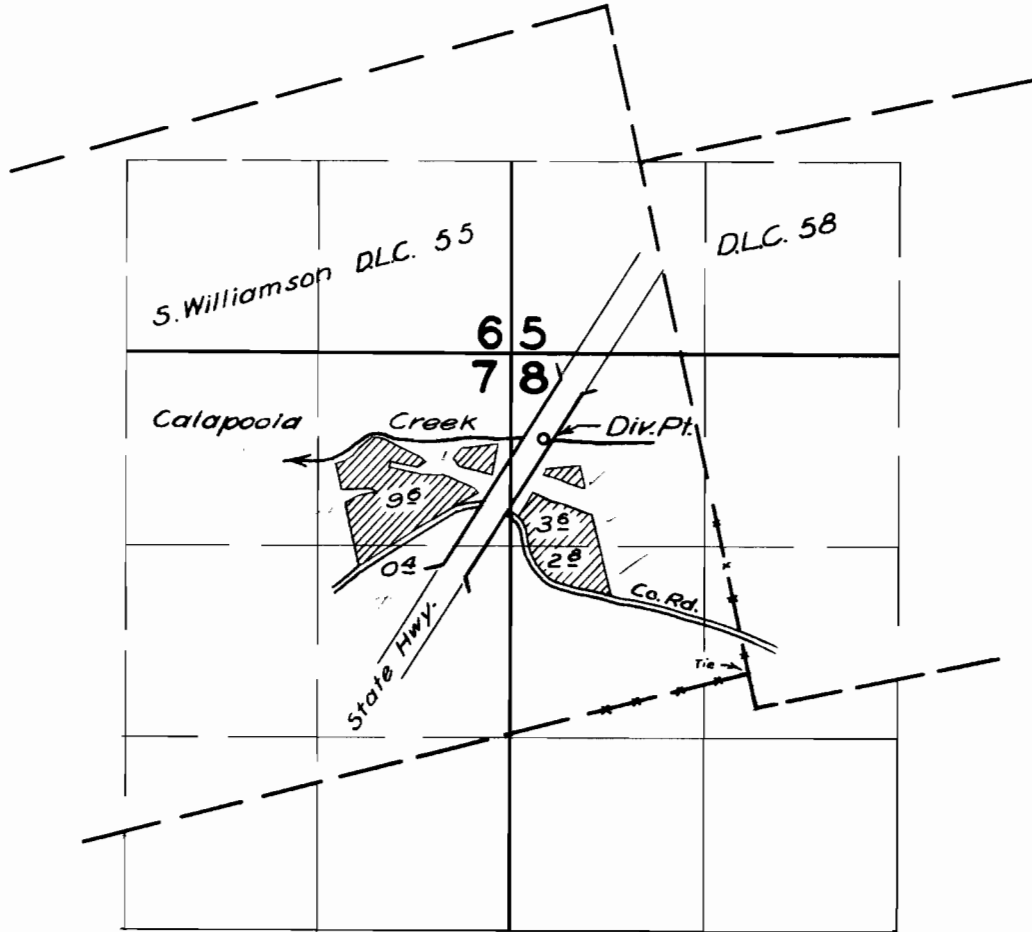

## FINAL PROOF SURVEY UNDER

Application No. 28520 Permit No. 22503  
IN NAME OF

Chas. P. Garrett

Surveyed Aug. 19 1957, by M. Bah