


T.27S. R.7W. W.M.

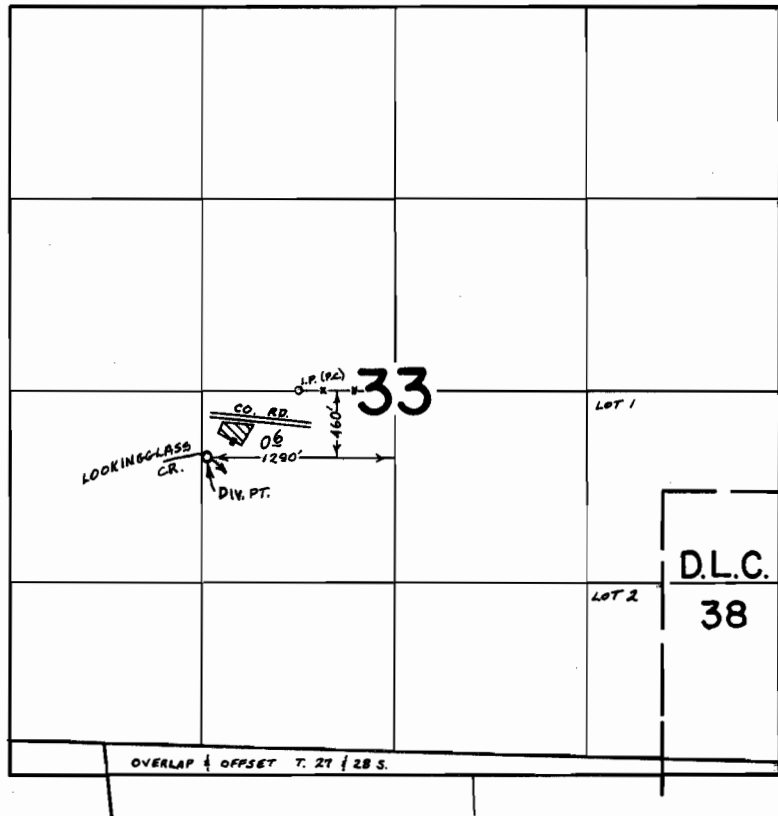

FINAL PROOF SURVEY UNDER

Application No. 42401 Permit No. 31587
IN NAME OF

MARSHALL H. & ADELLE M. SHERWIN

Surveyed MARCH 26, 1975, by L. TOLL