


RECEIVED

MAY 26 1983

WATER RESOURCES DEPT.
SALEM, OREGON

T.31S.,R.2W.,W.M.

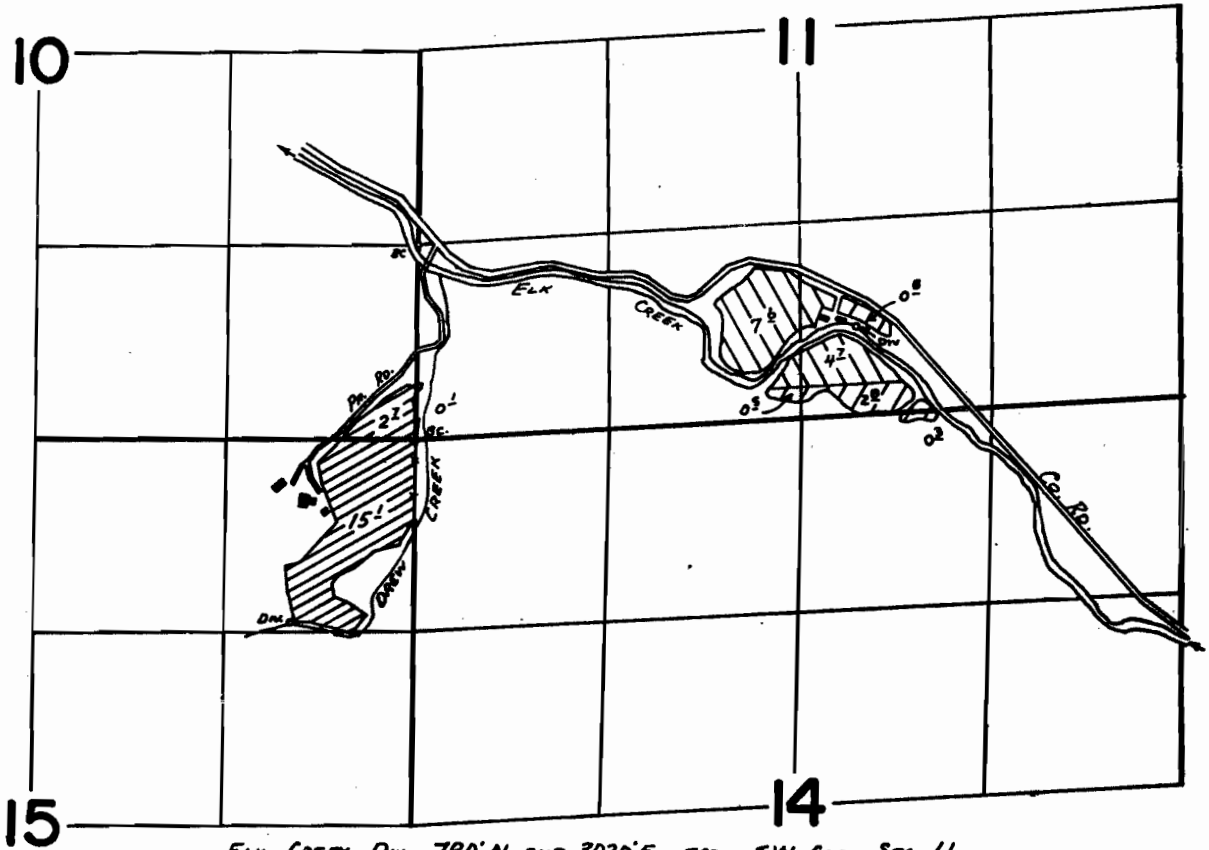

ELK CREEK DIV. - 780' N AND 3020' E FROM SW COR. SEC. 11
DREW CREEK DIV. - 1250' S AND 850' W FROM NE COR. SEC. 15

-  - DREW CREEK IRRIGATION (PERMIT 35115)
-  - ELK CREEK IRRIGATION (PERMIT 35115)
-  - ELK CREEK IRRIGATION (PERMIT 40224)

FINAL PROOF SURVEY
UNDER

Application No. 46961 Permit No. 35115
53911 40224
IN NAME OF

ROBERT E. & KAY C. OSLAR

Surveyed MAY 20 1975, by L. TALL