


T.32S. R.5W. W.M.

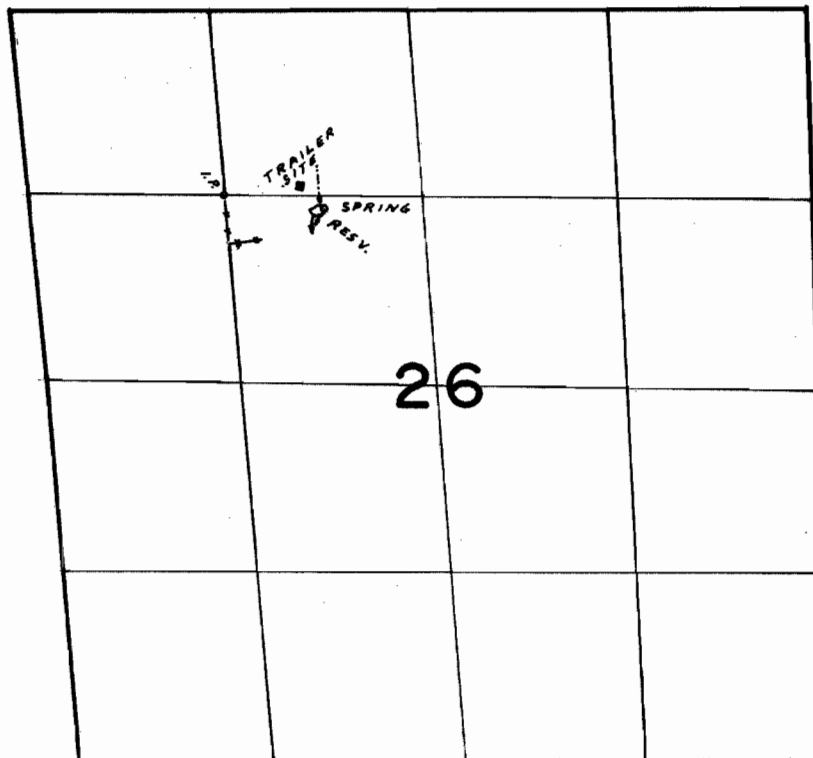

SPRING - 80'S & 690'E FROM CENTER
NW 1/4, SEC. 26.

FINAL PROOF SURVEY
UNDER

R-47515 R-5724
Application No. 47626 Permit No. 35603
IN NAME OF

BRUCE MOBUS

Surveyed MAY 20, 1975, by L.H. NUNN