


T. 27 & 28 S., R. 6 W., W.M.

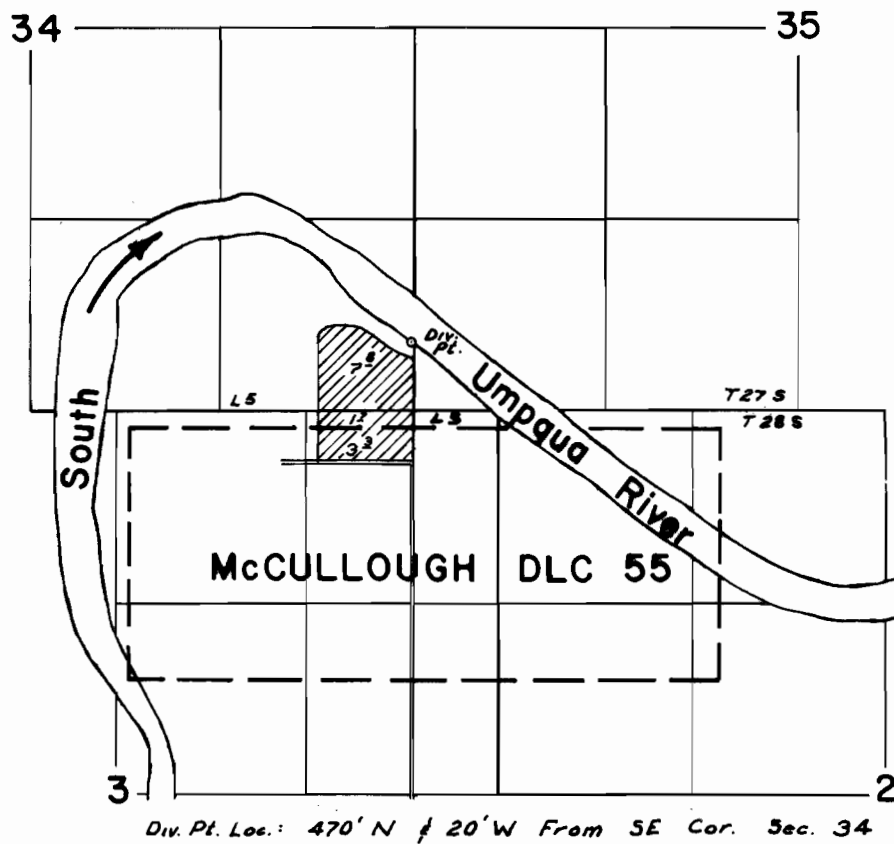

FINAL PROOF SURVEY
UNDER

Application No. 47994 Permit No. 35996
IN NAME OF

GEORGE R. INSLEY & THEODORE F. INSLEY

Surveyed NOV 5 1975, by D. NORBY