


T.30S.,R.2W.,W.M.

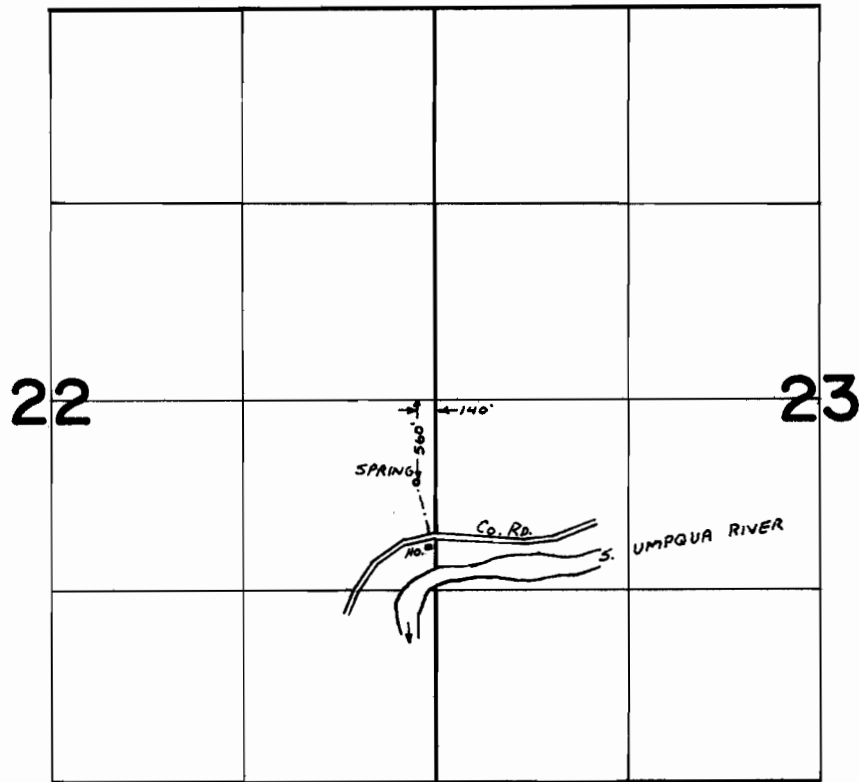

FINAL PROOF SURVEY

UNDER

Application No. **49725** Permit No. **36731**

IN NAME OF

WILLIAM E. & JUDITH J. STEINBACH

Surveyed *MAY 22 19 75*, by *L. Toll*