


T.24S. R.5W. W.M.

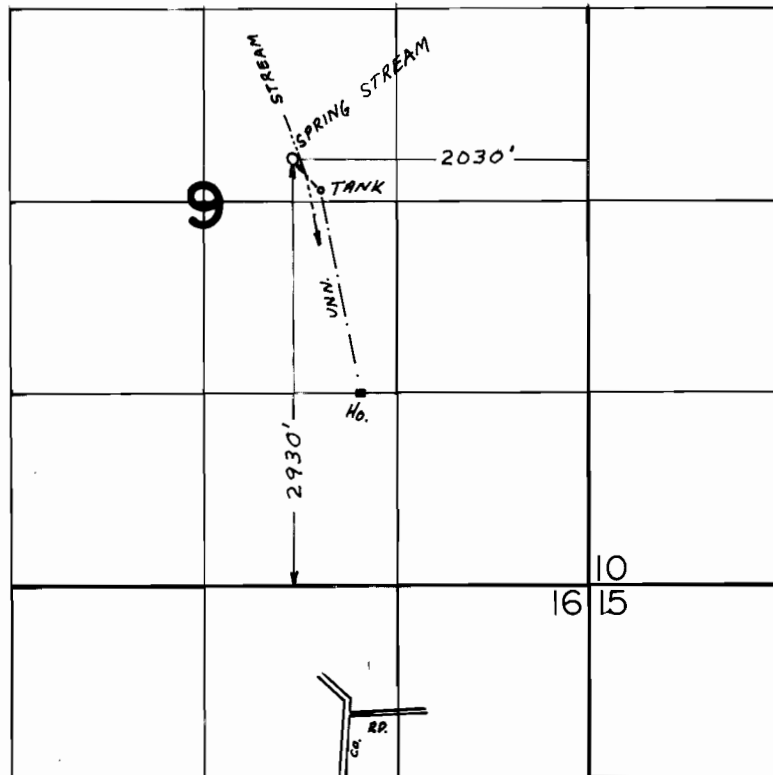

FINAL PROOF SURVEY
UNDER

Application No. 51108 Permit No. 38557
IN NAME OF

ERNEST R. & HAZEL A. SANDERSON

Surveyed AUG. 18. 1976. by L.H. NUNN