


T.13S. R.31E. W.M.

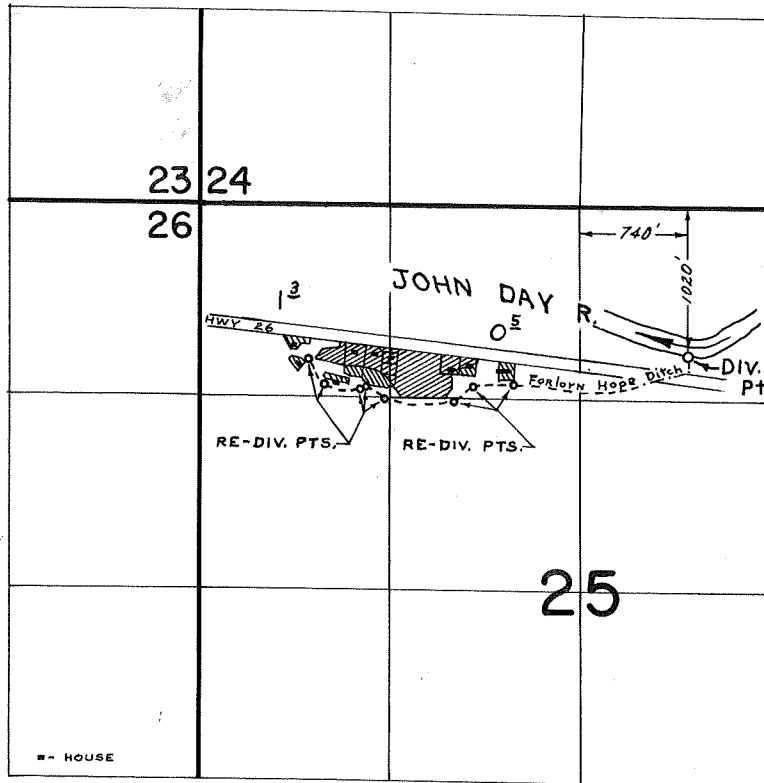

▨ - IRRIGATED LANDS UNDER THIS PERMIT
▨ - IRRIGABLE LANDS UNDER TRANSFER NO. B-189

FINAL PROOF SURVEY UNDER

Application No. 45193 Permit No. 33763
IN NAME OF

THE FORLOHN HOPE DITCH CO.
C/O A. WESTMORELAND
Surveyed JUNE 18th 21, 19 75, by R. MUCKEN