


34281

T. 9 S. R. 27 & 28 E. W. M.

See other P 34281  
Maps 68393  
44181

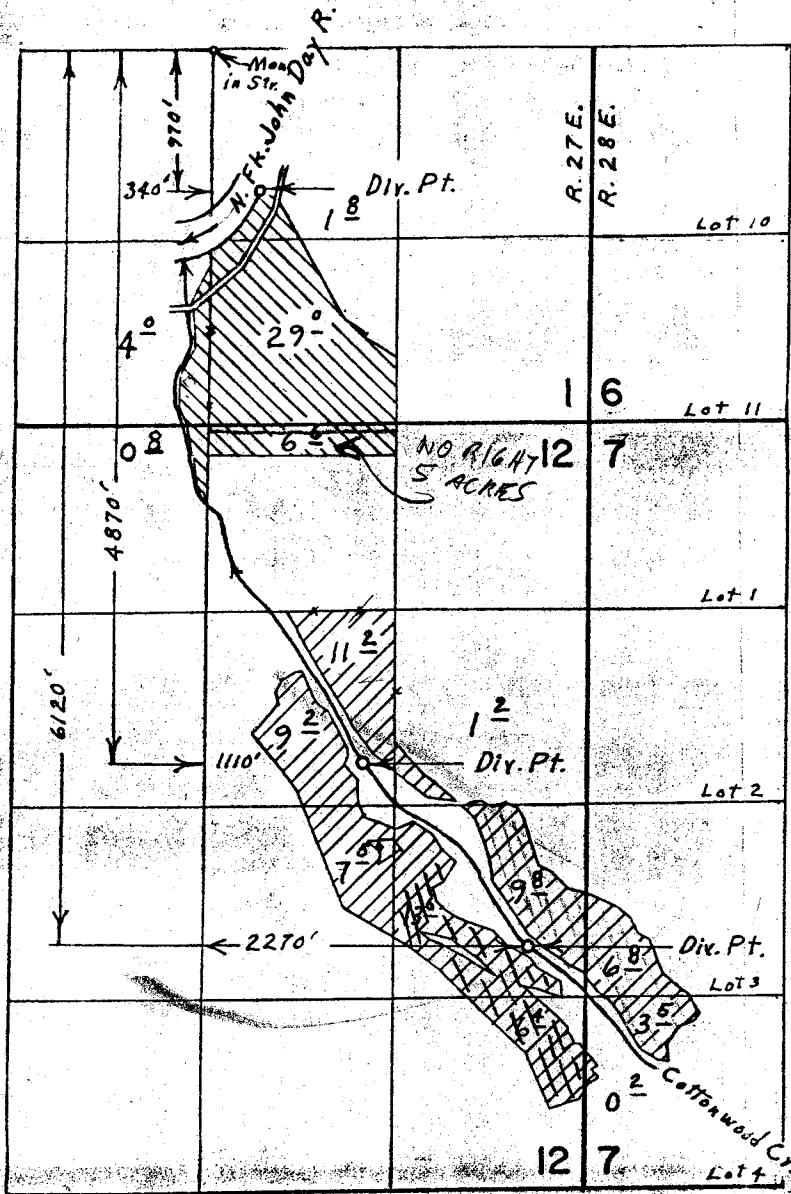

### FINAL PROOF SURVEY

UNDER

N. Fk. John Day R.

Cottonwood Cr.

Transfer M-199  
Transfer M-200

Application No. 45622 Permit No. 34281

IN NAME OF

**PHILIP MURPHY**

Surveyed July 20, 1971, by L. E. Gould

now C-44179