


T. 20S. R. 35E. W.M.

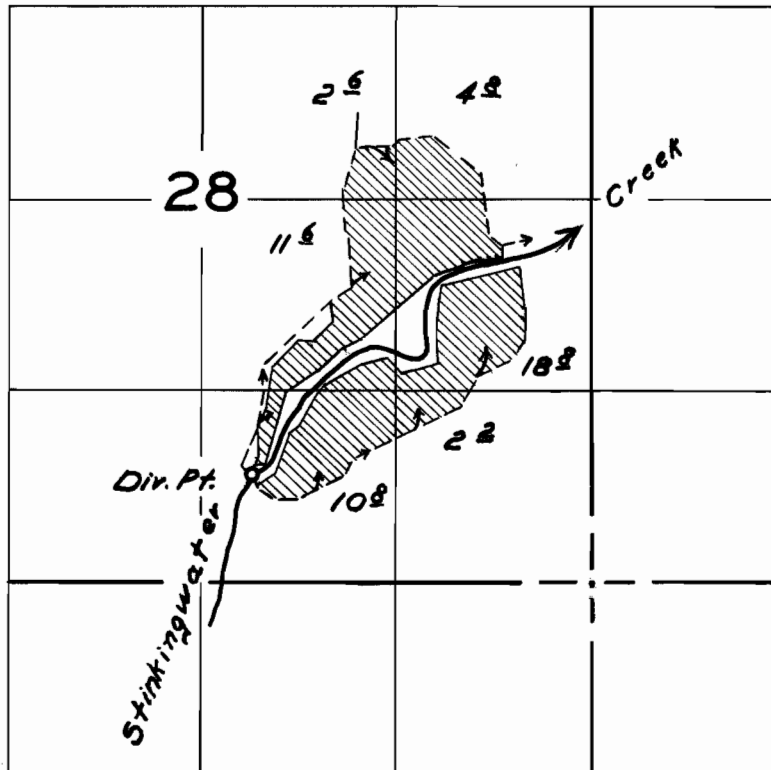

FINAL PROOF SURVEY
UNDER

Application No. 27592 Permit No. 21742
IN NAME OF

Anna O'Toole

Surveyed Aug. 20 1958, by W. N. Perry