


T.39S.R.2E.W.M.

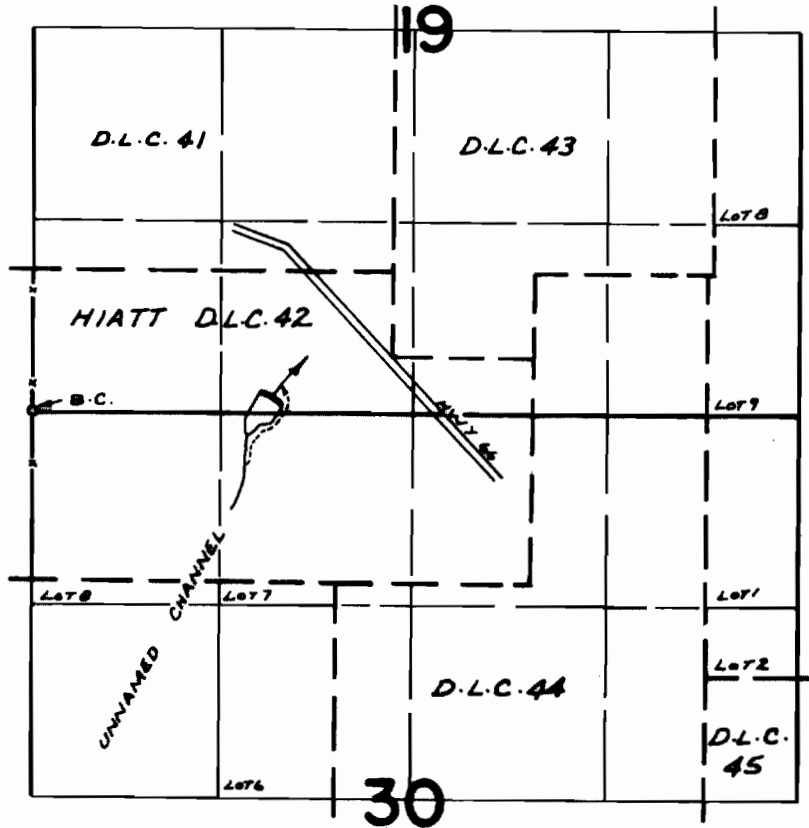

FINAL PROOF SURVEY UNDER

Application No. ~~R-12682~~ Permit No. ~~R-5854~~
IN NAME OF

~~CREEKSIDE COMMONS RANCH, INC.~~

Surveyed ~~SEPT. 19~~ 1974, by ~~R. MUCKEN~~