


T.34S. R.1W. W.M.

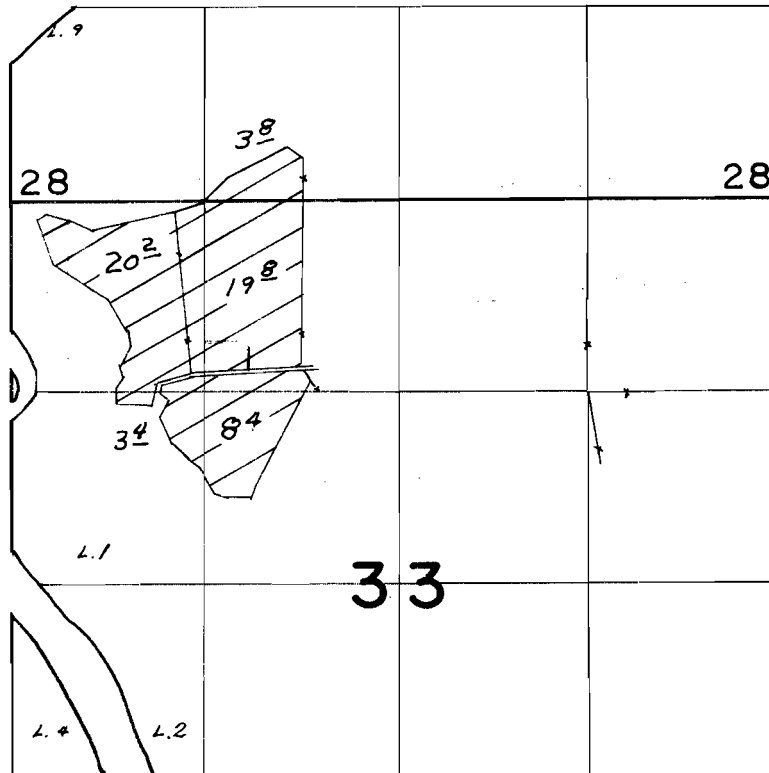

FINAL PROOF SURVEY
UNDER


Transfer No. R-108
Application No. _____ Permit No. _____
IN NAME OF

GINGER ROGERS

Surveyed APR. 26 1975, by L.H. NUNN

TOWNSHIP 34 S., RANGE 1 W.

8-4-4

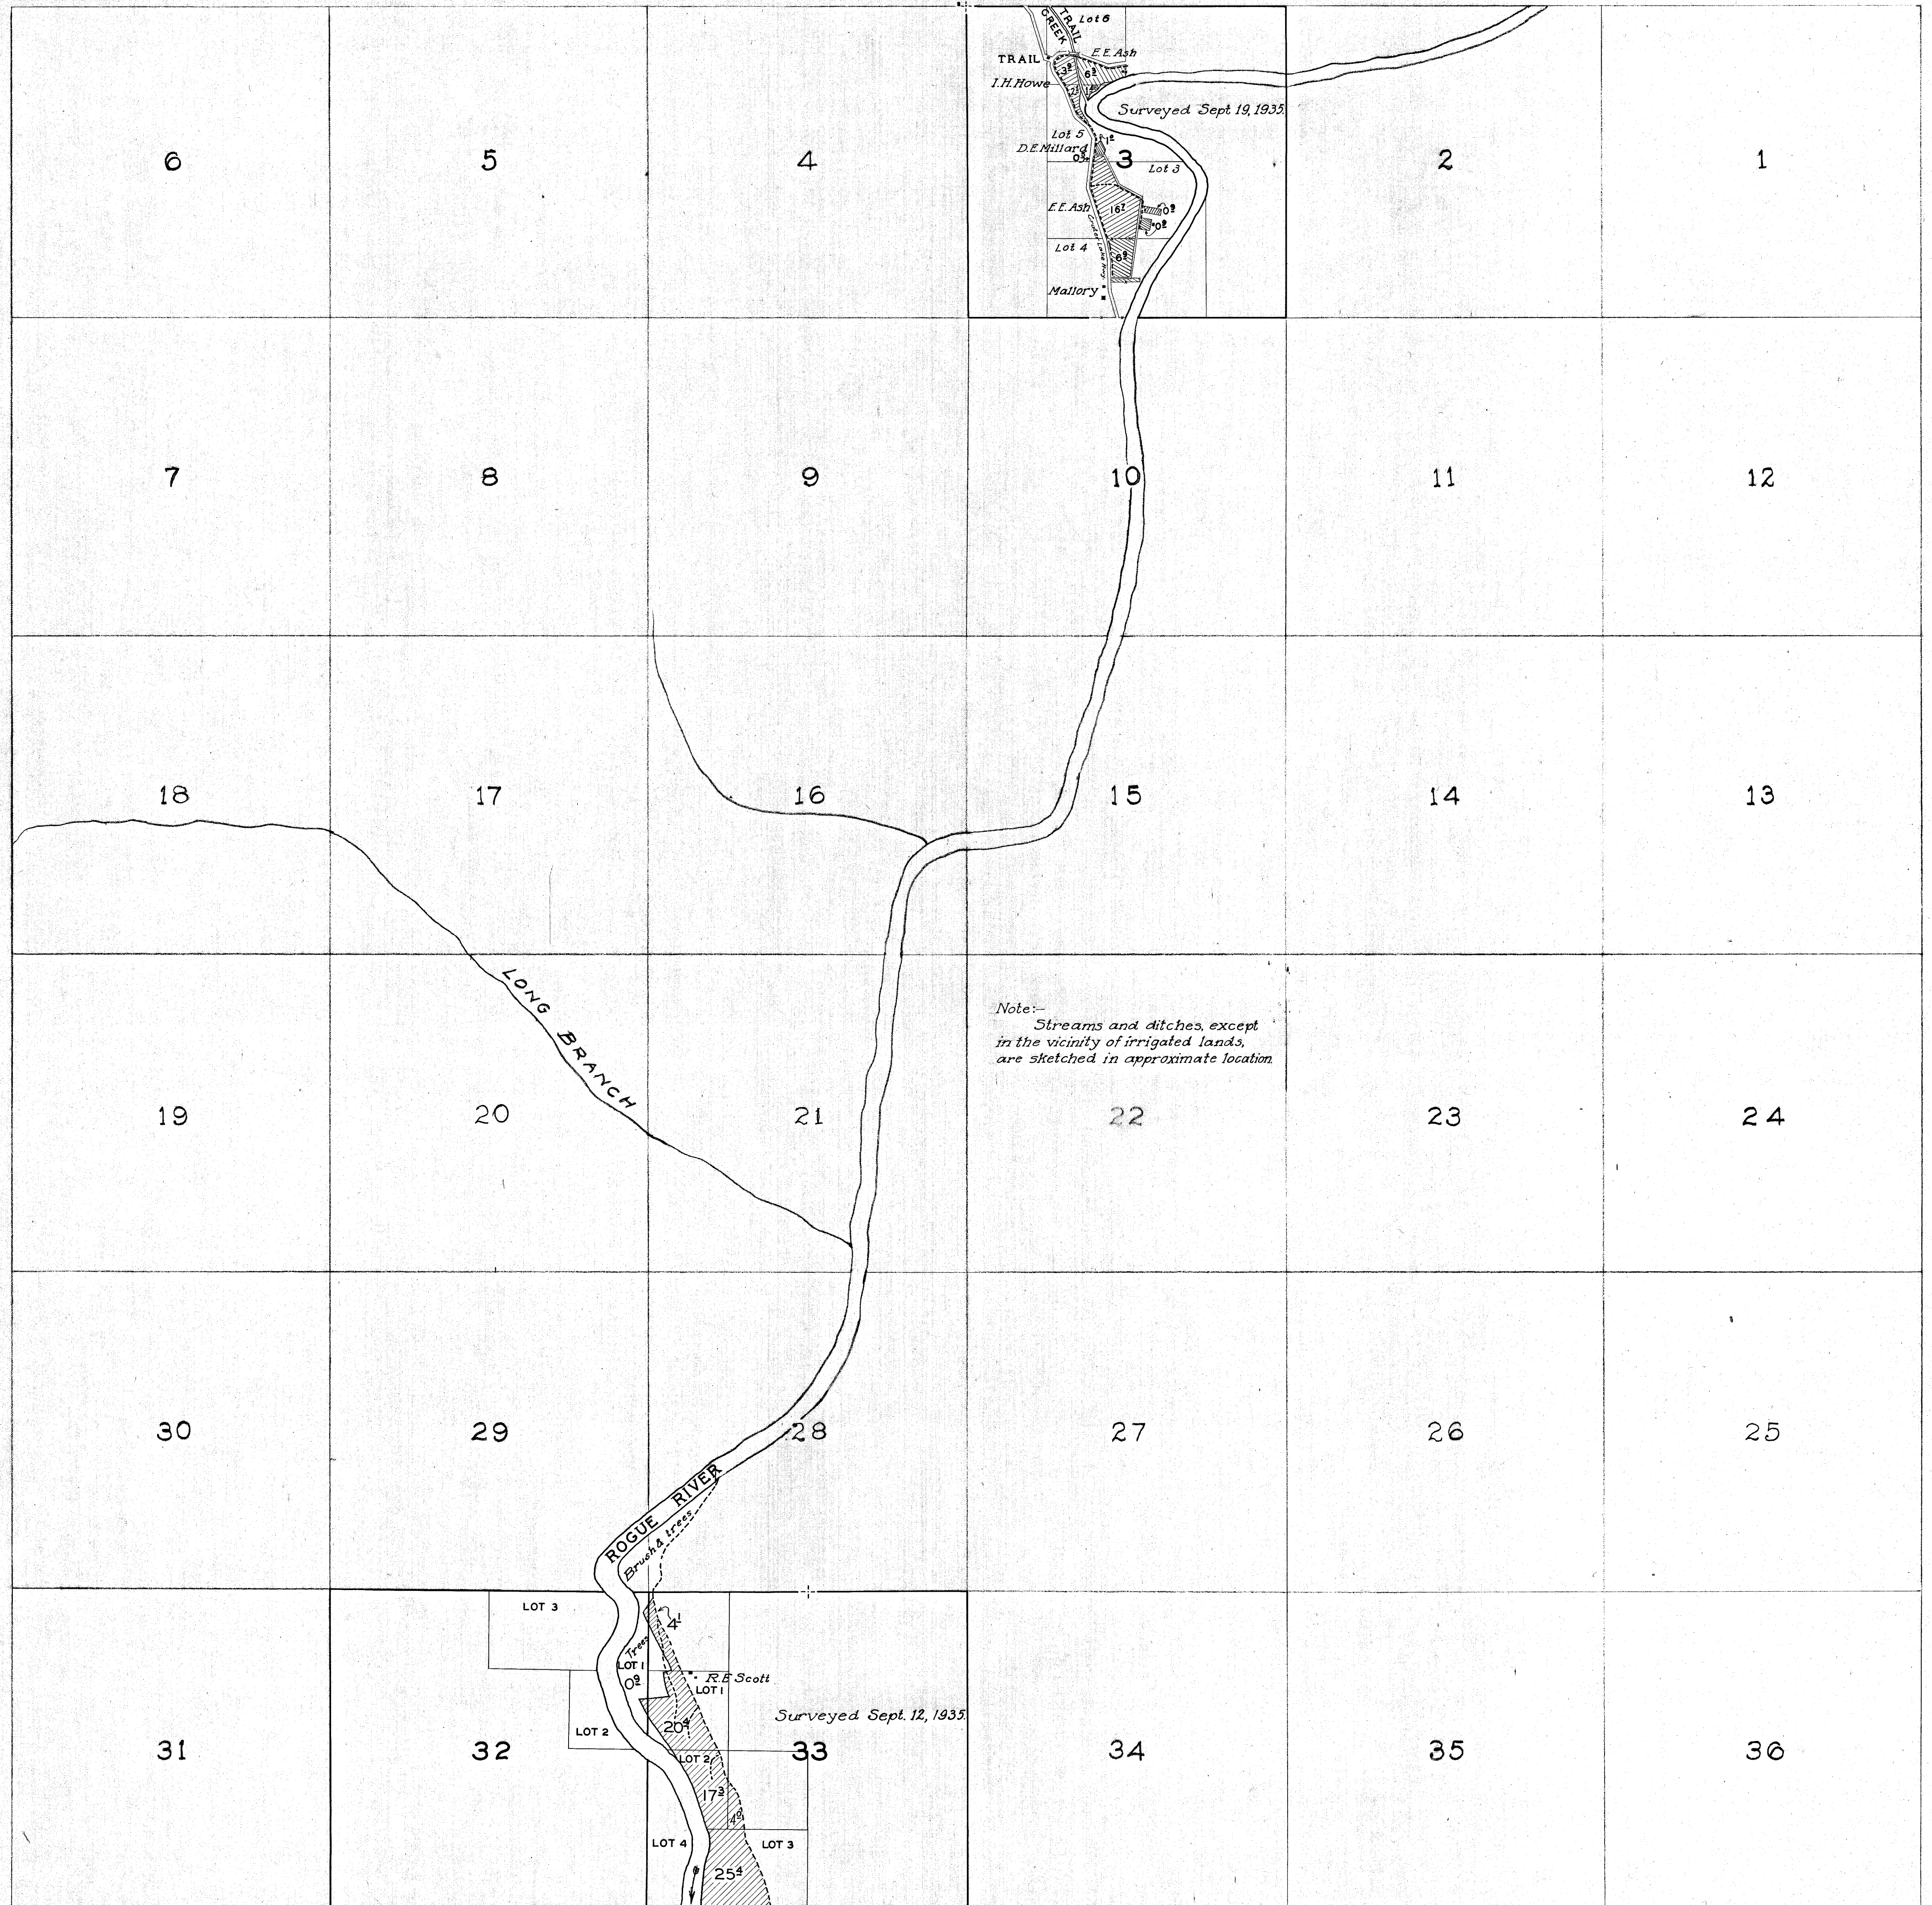

TOWNSHIP 35 S., RANGE 1 W.

14-4-4

