


T.38S.R.19E.W.M.

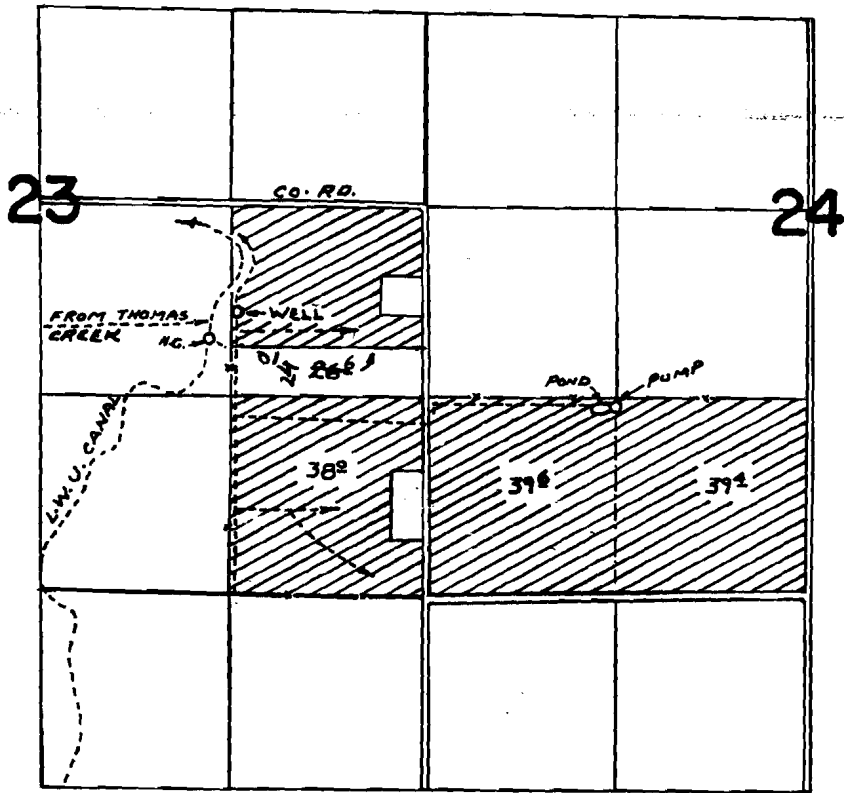

WELL LOC: 730'S. & 1280'W. FROM E 1/4 COR. SEC. 23

FINAL PROOF SURVEY UNDER

Application No. G-5707 Permit No. G-5515
IN NAME OF

HOWARD E. & MARY E. TOWNE

Surveyed OCT. 25, 1976. by R. MUGGEN